SURVEY &
REMONUMENTATION

MAR 13 1998

SECTION

MACKINAC COUNTY REMONUMENTATION CORNER

LAND CORNER RECORDATION CERTIFICATE

Filing Requirement of Act 74, Mich. P.A. 1970

For corners in

Mackinac (County)

	Located In:	Corner Code ##
1. Public Land Survey	T 41N R 3W	A-8
	T ___ R ___	W¼ Cor, Sec 19
	T 41N R 4W	M-8
	T ___ R ___	~~E¼ Cor, Sec 24~~
2. Property Controlling	S ___ T ___ R ___	
in Section	S ___ T ___ R ___	
3. Miscellaneous	S ___ T ___ R ___	
Property in Sec.	S ___ T ___ R ___	

RECEIVED & FILED
DIANE FRANKOVICH
MACKINAC COUNTY REGISTER OF DEEDS
DEC 29 1997
AM PM
7 8 9 10 11 12 1 2 3 4 5 6
Register of Deeds Stamp & File Number

4. Lot No. _____ , Recorded Plat _____
5. Private Claims _____

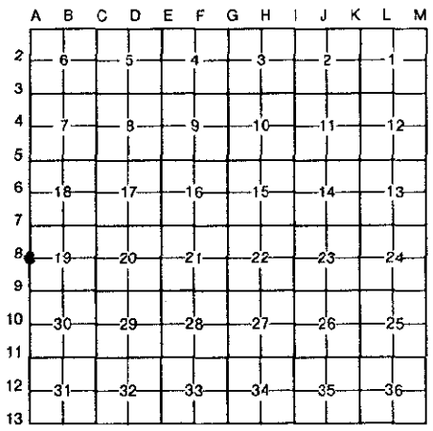

I, Neil E. Hill, in a field survey on DECEMBER 22 97, 19 _____, do hereby certify that under requirements of P.A. 74, Michigan P.A. of 1970, the corner points mentioned in lines 1 and 2 above were in conformance with regulations and rules therefore as required in the current manual of survey instructions of the United States Department of the Interior, Bureau of Land Management or by a decree of a Court of Law and/or that the corner points mentioned in lines 3, 4 and 5 above were in conformance with the rules of the Michigan Board of Land Surveyors or by a Decree of a Court of Law; established, re-established, monumented, re-monumented, recovered, found as expressed below:

NOTE: Not more than 4 corners, all in the same town and range, may be recorded on this certificate.

A. Description of original monument and accessories and/or subsequent restoration:

1840 GLO notes William Burt 6" Cottonwood N5W 22 lks
5" B. Ash S1E 32 lks

1984 James Granger found ½" iron in gravel road
Recorded Liber C, page 75

B. *Description of corner evidence found and/or method applied in restoring or reestablishing corner:*

1997 Found ¾" iron in blacktop road (Old witnesses)
12" Poplar N56W 52.90'
P.P. (E-7) N12E 143.08'
P.P. (E-6) S21E 64.98' (Old tag not there)
Accepted corner location.

ACCEPTED BY THE MACKINAC COUNTY SURVEY PEER GROUP AS THE OFFICIAL CORNER UNDER P.A. 345 OF 1990 AT A MEETING HELD ON 12-12-97

C. Description of monument for corner and accessories established to perpetuate locating the position of the corner:

1997 Found ¾" pipe over ½" iron next to wood post.
12" Poplar (dead) N56W 52.90'
P.P. (E-7) N12E 143.08'
P.P. (E-6) S21E 64.83' (Dbl. head nail)
6" Poplar S85E 46.31'
½" Rod Due West 33.00'
Placed ½" rerod with remonumentation cap and monument box over found corner.

STATE OF MICHIGAN
NEIL E. HILL
Land Surveyor
No. 27447
REGISTERED LAND SURVEYOR

Signed by Neil E. Hill P.S. Date DECEMBER 22, 1997

Surveyor's Michigan License No. 27447

FORM APPROVED BY MICHIGAN STATE BOARD OF LAND SURVEYORS, JAN. 28, 1971
REVISED MAY 14, 1975
REVISED JAN., 1983

E-164