SURVEY & REMONUMENTATION

MAR 13 1998

SECTION

MACKINAC COUNTY REMONUMENTATION CORNER

LAND CORNER RECORDATION CERTIFICATE

Filing Requirement of Act 74, Mich. P.A. 1970

RECEIVED & FILED
DIANE FRAPKOVICH
MACKINAC COUNTY REGISTER OF DEEDS
DEC 29 1997
AM PM

Register of Deeds Stamp & File Number

For corners in Mackinac (County)

	Located In:	Corner Code 11
1. Public Land Survey	T 41N R 3W	A-9
	T ___ R ___	Sec Cor common
	T ___ R ___	to Sec's 19 & 30
	T 41N R 4W	M-9, Sec Cor common
2. Property Controlling	S ___ T ___ R ___	to Sec's 24 & 25
in Section	S ___ T ___ R ___	
3. Miscellaneous	S ___ T ___ R ___	
Property in Sec.	S ___ T ___ R ___	

4. Lot No. _____ , Recorded Plat _____
5. Private Claims _____

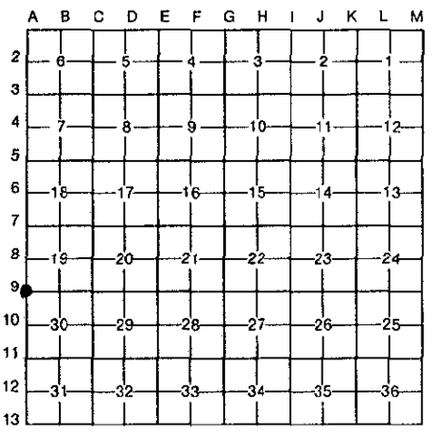

I, Neil E. Hill, *in a field survey on* DECEMBER 22 97, 19 _____, do hereby certify that under requirements of P.A. 74, Michigan P.A. of 1970, the corner points mentioned in lines 1 and 2 above were in conformance with regulations and rules therefore as required in the current manual of survey instructions of the United States Department of the Interior, Bureau of Land Management or by a decree of a Court of Law and/or that the corner points mentioned in lines 3, 4 and 5 above were in conformance with the rules of the Michigan Board of Land Surveyors or by a Decree of a Court of Law; established, re-established, monumented, re-monumented, recovered, found as expressed below:

***NOTE:* Not more than 4 corners, all in the same town and range, may be recorded on this certificate.**

A. Description of original monument and accessories and/or subsequent restoration:

1845 GLO notes William Burt 6" Aspen N60W 23 lks
5" Aspen S42W 16 lks

No records of this corner being perpetuated, however various surveys indicate this corners position
1992 Survey by Meridian Consultants.

B. *Description of corner evidence found and/or method applied in restoring or reestablishing corner:*

1997 Found 1½" iron pipe. Accepted corner location.

ACCEPTED BY THE MACKINAC COUNTY SURVEY PEER GROUP AS THE OFFICIAL CORNER UNDER P.A. 345 OF 1990 AT A MEETING HELD ON 12-12-97

C. Description of monument for corner and accessories established to perpetuate locating the position of the corner:

Set ⅝" iron with remonumentation cap inside found pipe.
4" Cedar S20W 13.75'
8" Cedar S65W 19.05'
8" Poplar N45W 16.58'
6" Poplar N60E 17.84'

STATE OF MICHIGAN
NEIL E. HILL
Land Surveyor
No. 27447
REGISTERED LAND SURVEYOR

Signed by Neil E. Hill P.S. Date DECEMBER 22, 1997

Surveyor's Michigan License No. 27447

FORM APPROVED BY MICHIGAN STATE BOARD OF LAND SURVEYORS, JAN. 28, 1971
REVISED MAY 14, 1975
REVISED JAN., 1983

E- 165