


JAN 21 1999

# T42N R01E SECTION

Clark Twp.

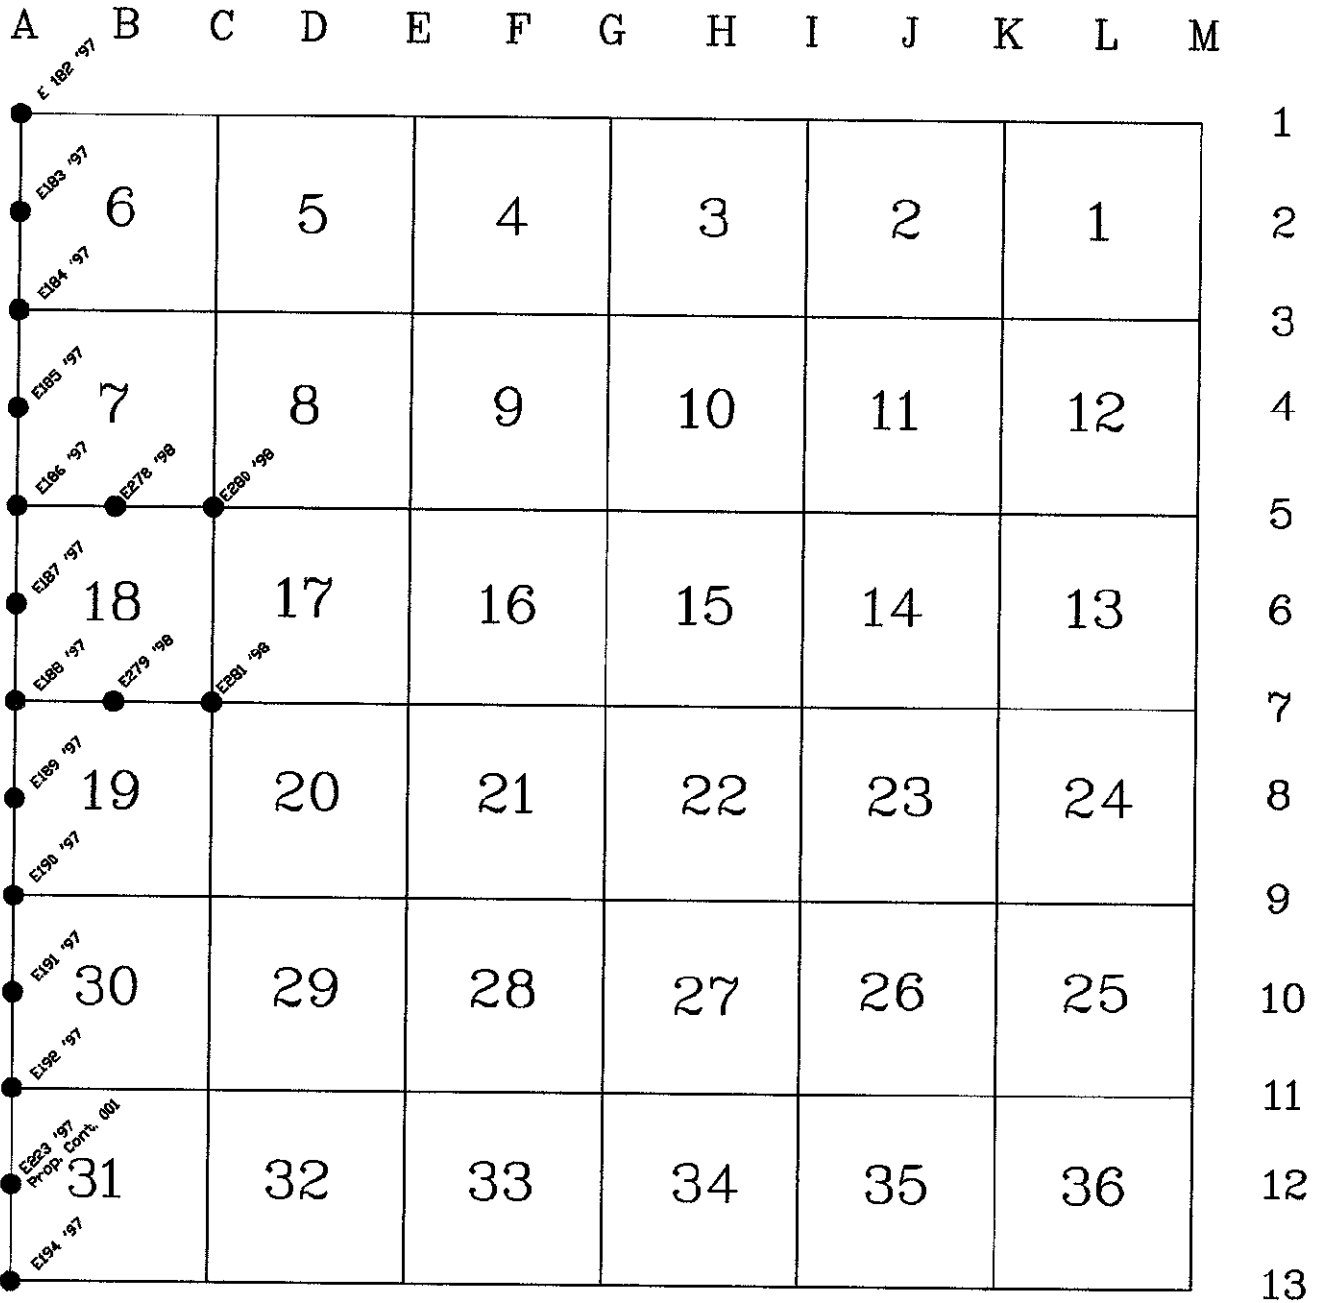

- Denotes Set ReMonumentation Corner in 1998
- Denotes Previously Set ReMonumentation Corner