T42N R01E

Clark Twp.

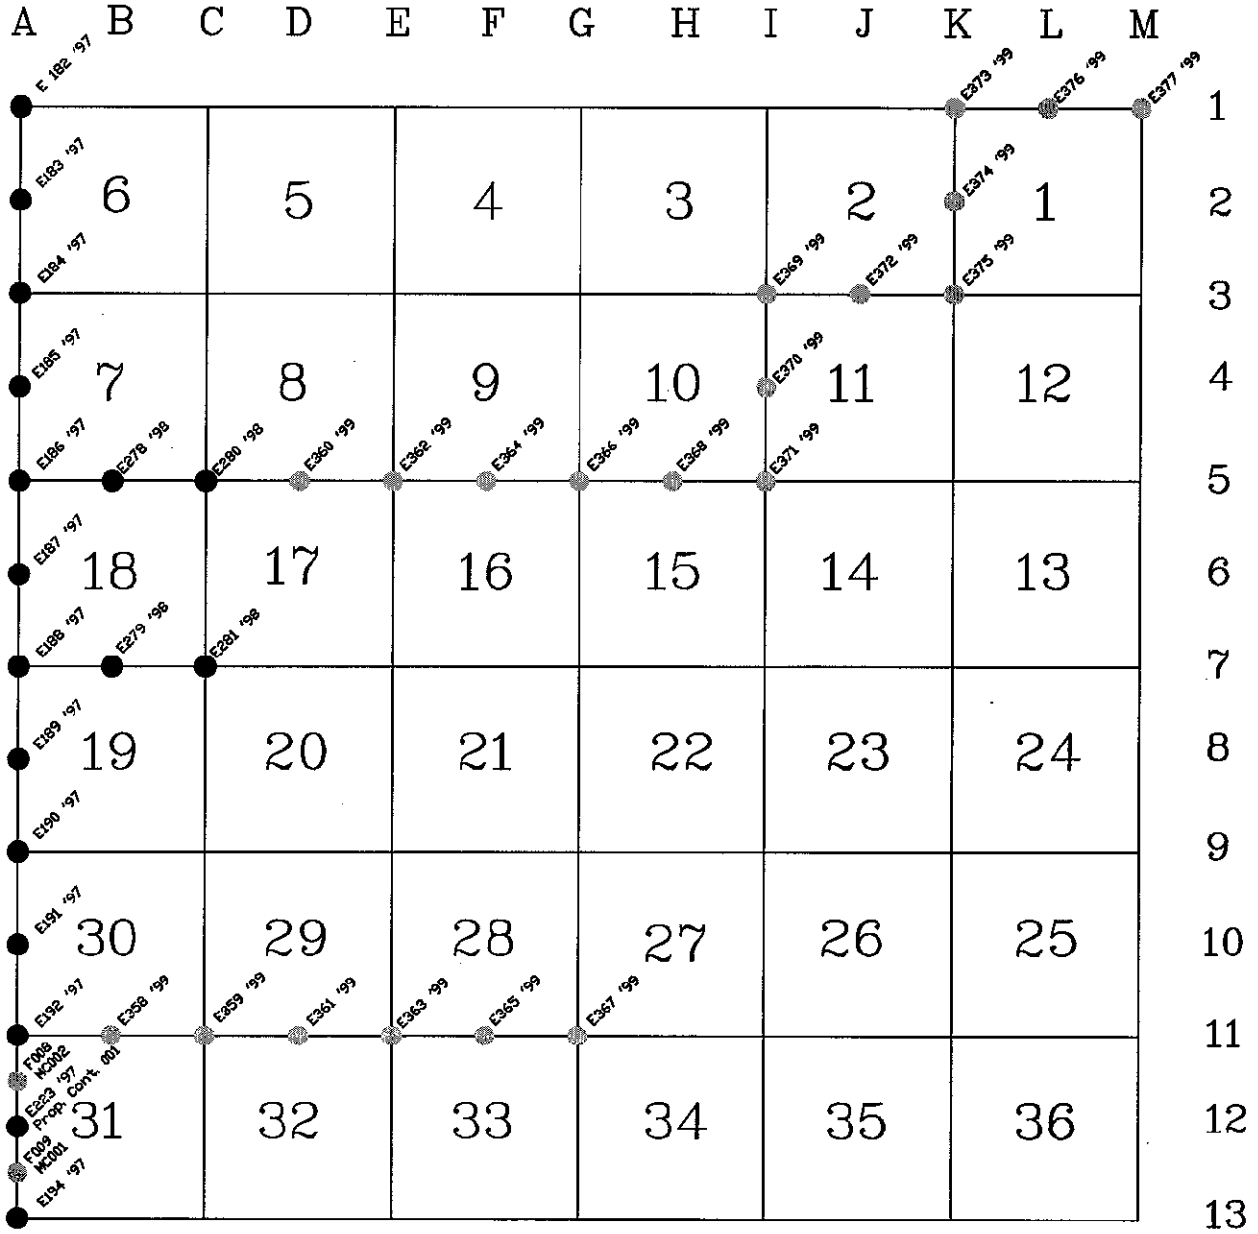

Denotes Set ReMonumentation Corner in 1999

Denotes Previously Set ReMonumentation Corner

SURVEY &
RE[illegible]
MAR 01 2000
SECTION