

# SURVEY & REMONUMENTATION

MAR 13 1998

1997 Mackinac County Remonumentation Corner  
**LAND CORNER RECORDATION CERTIFICATE**  
 Filing Requirement of Act 74, Mich. P.A. 1970

## SECTION

For corners in

<u>Mackinac</u> (County)	Located In:	Corner Code #
1. Public Land Survey	T 42NR 1W <del>T 42NR 1E</del> T ___ R ___ T ___ R ___	M-4 <u>A-4</u> ✓
2. Property Controlling in Section	S ___ T ___ R ___ S ___ T ___ R ___	_____
3. Miscellaneous Property in Sec.	S ___ T ___ R ___ S ___ T ___ R ___	_____

RECEIVED & FILED  
 DIANE FRANKOVICH  
 MACKINAC COUNTY CLERK OF DEEDS

DEC 31 1997  
 AM PM  
 718(91) (1) (2) (3) (4) (5) (6)

Register of Deeds Stamp & File Number

4. Lot No. \_\_\_\_\_, Recorded Plat \_\_\_\_\_  
 5. Private Claims \_\_\_\_\_

I, David B. Guthrie, in a field survey on Dec. 17, 1997 do hereby state that under requirements of P.A. 74, Michigan P.A. of 1970, the corner points mentioned in lines 1 and 2 above were in conformance with regulations and rules therefore as required in the current manual of survey instructions of the United States Department of the Interior, Bureau of Land Management or by a decree of a Court of Law and /or that the corner points mentioned in lines 3, 4 and 5 above were in conformance with the rules of the Michigan Board of Land Surveyors or by a Decree of a Court of Law; established, re-established, monumented, recovered, found as expressed below:

NOTE: Not more than 2 corners, all in the same town and range, may be recorded on this certificate.

A	B	C	D	E	F	G	H	I	J	K	L	M
1												
2	6		5		4		3		2		1	
3												
4	7		8		9		10		11		12	
5												
6	18		17		16		15		14		13	
7												
8	19		20		21		22		23		24	
9												
10	30		29		28		27		26		25	
11												
12	31		32		33		34		35		36	
13												

A. Description of original monument and accessories and/or subsequent restoration:

1840: G.L.O. Survey by Wm. A. Burt - Set Post and Referenced -  
 Cedar 10 / S8W / 12  
 Tamarack 12 / N66W / 9

1992: Survey by Neil Hill - Found 1/2" Copper clad rod in Ely side of Monument Box.  
 Liber D Page 137


B. Description of corner evidence found and/or method applied in restoring or reestablishing corner:

1997: Remonumentation survey by R.S. Scott Associates, Inc.  
 Found 1/2" rod in Monument Box.  
 This corner position is compatible with County and local surveys. This corner position accepted as a careful and faithful perpetuation of the position of the original corner.

ACCEPTED BY THE MACKINAC COUNTY  
 SURVEY PEER GROUP AS THE  
 OFFICIAL CORNER UNDER PA.  
 345 OF 1990 AT A MEETING  
 HELD ON 12-19-97

C. Description of monument for corner and accessories established to perpetuate locating the position of the corner:

1997: Placed a 3" Mackinac County Cap stamped to identify the corner over 1/2" Iron Rod in Monument Box.  
 Referenced -  
 (Exist.) Tag#22428 - S60°W - 90.45' - 14" Spruce  
 (Exist.) MDOT Tag - S85°W - 77.62' - 12" Poplar  
 (Exist.) MDOT Tag - N70°W - 76.34' - 10" Poplar  
 (Exist.) Tag#22428 - S45°E - 80.21' - P.P.

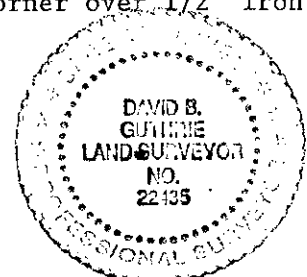

Signed by David B. Guthrie  
 Surveyor's Michigan License No. 22435

Date: 12-22-97