

SURVEY & REMONUMENTATION

MAR 13 1998

1997 Mackinac County Remonumentation Corner

LAND CORNER RECORDATION CERTIFICATE Filing Requirement of Act 74, Mich. P.A. 1970

For corners in SECTION

Mackinac
(County)

Located In: Corner Code #

- | | | |
|------------------------------------|-------------------|--------------|
| 1. Public Land Survey | T <u>42NR 1W</u> | M-5 |
| | T <u>42NR 1E</u> | <u>A-5</u> ✓ |
| | T ___ R ___ | ___ |
| | T ___ R ___ | ___ |
| 2. Property Controlling in Section | S ___ T ___ R ___ | ___ |
| | S ___ T ___ R ___ | ___ |
| 3. Miscellaneous Property in Sec. | S ___ T ___ R ___ | ___ |
| | S ___ T ___ R ___ | ___ |

RECEIVED & FILED
DIANE FRANKOVICH
MACKINAC COUNTY ARCHISTE OF DEEDS

DEC 31 1997
AM PM
7:18:19

Register of Deeds Stamp & File Number

4. Lot No. _____, Recorded Plat _____
5. Private Claims _____

I, David B. Guthrie, in a field survey on Dec. 17, 1997 do hereby state that under requirements of P.A. 74, Michigan P.A. of 1970, the corner points mentioned in lines 1 and 2 above were in conformance with regulations and rules therefore as required in the current manual of survey instructions of the United States Department of the Interior, Bureau of Land Management or by a decree of a Court of Law and /or that the corner points mentioned in lines 3, 4 and 5 above were in conformance with the rules of the Michigan Board of Land Surveyors or by a Decree of a Court of Law; established, re-established, monumented, recovered, found as expressed below:

NOTE: Not more than 2 corners, all in the same town and range, may be recorded on this certificate.

	A	B	C	D	E	F	G	H	I	J	K	L	M
1													
2		6		5		4		3		2		1	
3													
4		7		8		9		10		11		12	
5													
6		18		17		16		15		14		13	
7													
8		19		20		21		22		23		24	
9													
10		30		29		28		27		26		25	
11													
12		31		32		33		34		35		36	
13													

A. Description of original monument and accessories and/or subsequent restoration:

1840: G.L.O. Survey by Wm. A. Burt - Set Post and Referenced -
Pine 12 / S22W / 20
Cedar 10 / N19W / 14

1992: Survey by Neil Hill - Found boat spike in Monument Box, 1' East of exist. M-129 C.L.
Liber D Page 136

B. Description of corner evidence found and/or method applied in restoring or reestablishing corner:

1997: Remonumentation survey by R.S. Scott Associates, Inc.
Found boat spike in Monument Box.


This corner position is compatible with County and local surveys. This corner position is accepted as a careful and faithful perpetuation of the position of the original corner.

ACCEPTED BY THE MACKINAC COUNTY SURVEY PEER GROUP AS THE OFFICIAL CORNER UNDER P.A. 345 OF 1990 AT A MEETING HELD ON 12-19-97

C. Description of monument for corner and accessories established to perpetuate locating the position of the corner:

1997: Placed a 3" Mackinac County Cap stamped to identify the corner over 1/2" Iron Rod in a Monument Box.

Referenced -
(Exist.) MDOT Tag - N45°E - 106.21' - P.P.
S65°E - 74.65' - P.P.
S75°W - 78.16' - Guy Pole
(Exist.) MDOT Tag - N45°W - 87.11' - 4" Spruce

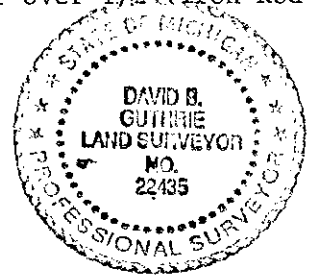

Signed by D.B. Guthrie
Surveyor's Michigan License No. 22435

Date 12-22-97