

MAR 20 2000

LAND CORNER RECORDATION CERTIFICATE
Filing Requirement of Act 74, Mich. P.A. 1970

SECTION

Mackinac County Remonumentation Corner


For corners in

Mackinac County	Located in:	Corner Code #
1. Public Land Survey	T42N R01E	I-5
	T R	
	T R	
	T R	
2. Property Controlling in Section	S T R	
	S T R	
3. Miscellaneous Property in Sec.	S T R	
	S T R	
4. Lot No. , Recorded Plat		
5. Private Claims		

RECEIVED & FILED
DIANE FRANKOVICH
 MACKINAC COUNTY REGIST. OF DEEDS
FEB 25 2000
 AM PM
 21619101111211213141516
Register of Deeds Stamp & File Number

I, Neil E. Hill, in a field survey on 12-20-99, do hereby state that under requirements of P.A. 74, Michigan P.A. of 1970, the corner points mentioned in lines 1 and 2 above were in conformance with regulations and rules therefore as required in the current manual of survey instructions of the United States Department of the Interior, Bureau of Land Management or by a decree of a Court of Law and for that the corner points mentioned in lines 3, 4 and 5 above were in conformance with the rules of the Michigan Board of Land Surveyors or by a Decree of a Court of Law; established, re-established, monumented, recovered, found as expressed below:

NOTE: Not more than 2 corners, all in the same town and range, may be recorded on this certificate.

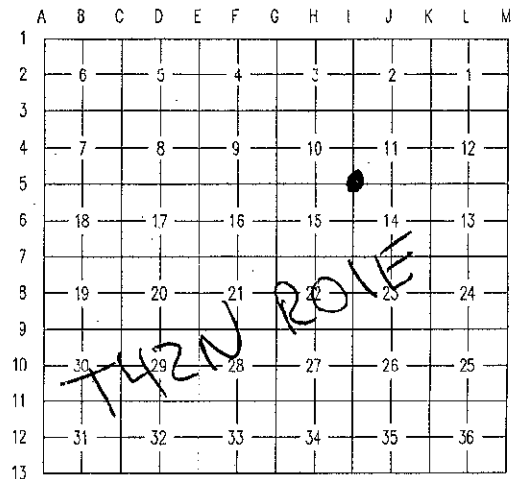

A. Description of original monument and accessories and/or subsequent restoration:

1845 GLO Notes J Mullet	6" Cedar	S 13 W	6 lks
	12" Fir	N 36 E	6 lks
1947 G F Delameter	Fd 1" Axle Shaft		
1966 Unkown Surveyor for US Steel Corp.	Fd 1" Axel Shaft, and noted on survey of Sections 3 & 10		
1981 Billy Buckler DNR	40" Bolder	S 50 W	138.4'
	Fd 1" Axle shaft	S end culvert S 77 E	46.0'
	Liber B, Page 250		
1994 James Granger	8" Twn Birch	N 10 W	25.51'
	Fd 2 witnesses, and	1" Pipe Due N	2.00'
	1" pipe 2' North Per DNR	8" Cedar S 41 N	47.01'
	Survey, replaced	10" Cedar S 15 E	26.62'
	as per witnesses	40" Boulder S 50 W	138.40'
	Liber D, Page 300	S end culvert S 77 E	46.00'

ACCEPTED BY THE MACKINAC COUNTY SURVEY PEER GROUP AS THE OFFICIAL CORNER UNDER PA. 345 OF 1990 AT A MEETING HELD ON 12-10-99

Neil E. Hill

No Subsequent Information

B. Description of corner evidence found and/or method applied in restoring or reestablishing corner:

1999 Fd 1/2" rod and 4 witnesses
 Accepted corner location
 Placed 4" Alum. remonumentation cap

C. Description of monument for corner and accessories established to perpetuate locating the position of the corner:

Corner is 1/2 rod with 4" Alum remonumentation cap
 Corner is approx 5' South of CL gravel Rd

10" Twn Birch	N 10 W	25.45'
8" Cedar	S 41 W	46.98'
10" Cedar	S 15 E	26.70'
8" Poplar	S 10 W	19.51'
1" Pipe	Due N	2.00'

Bearings are compass bearings, corrected for declination, all distances are to a double-head nail in the side of the witness object unless otherwise noted.

Signed by Neil E. Hill P.S., P.C.

Date January 21 2000

Surveyor's Michigan License No. 27447