SURVEY &
REMONUMENTATION

MAR 20 2000

SECTION

LAND CORNER RECORDATION CERTIFICATE
Filing Requirement of Act 74, Mich. P.A. 1970

Mackinac County Remonumentation Corner

For corners in

Mackinac County	Located in:			Corner Code #
1. Public Land Survey		T42N	R01E	K-2
		T	R	
		T	R	
		T	R	
2. Property Controlling	S	T	R	
in Section	S	T	R	
3. Miscellaneous	S	T	R	
Property in Sec.	S	T	R	

RECEIVED & FILED
DIANE FRANKOVICH
MACKINAC COUNTY REGISTER OF DEEDS
FEB 25 2000
AM PM
Register of Deeds Stamp & File Number

4. Lot No. , Recorded Plat
5. Private Claims

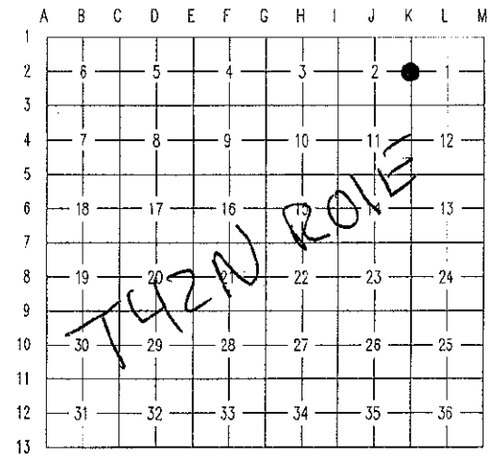

I, Neil E. Hill, in a field survey on 12-20-99, do hereby state that under requirements of P.A. 74, Michigan P.A. of 1970, the corner points mentioned in lines 1 and 2 above were in conformance with regulations and rules therefore as required in the current manual of survey instructions of the United States Department of the Interior, Bureau of Land Management or by a decree of a Court of Law and /or that the corner points mentioned in lines 3, 4 and 5 above were in conformance with the rules of the Michigan Board of Land Surveyors or by a Decree of a Court of Law; established, re-established, monumented, recovered, found as expressed below:

NOTE: Not more than 2 corners, all in the same town and range, may be recorded on this certificate.

A. Description of original monument and accessories and/or subsequent restoration:

1845 GLO Notes J Mullett	8" Fir	S 66 W	10 lks
	8" Aspen	S 85 E	8 lks

No Subsequent Information

ACCEPTED BY THE MACKINAC COUNTY SURVEY PEER GROUP AS THE OFFICIAL CORNER UNDER P.A. 345 OF 1990 AT A MEETING HELD ON 12-10-99
Neil E. Hill

B. Description of corner evidence found and/or method applied in restoring or reestablishing corner:

1999 Fd no evidence of original or subsequent corner location
Placed ½" rod with 4" Alum. remonumentation cap on line at pro-rated GLO distance.

C. Description of monument for corner and accessories established to perpetuate locating the position of the corner:

Corner is a ½"rod with 4" Alum remonumentation cap
Corner is 5' West from the Edge, and 7' East of the CL of gravel road

6" Spruce	S 85 W	29.78'
4" Spruce	N 55 W	39.06'
4" W Birch	N 60 E	82.61'
18" Norway	S 30 E	93.15'

STATE OF MICHIGAN
NEIL E. HILL
Land Surveyor
No. 27447
REGISTERED LAND SURVEYOR

Bearings are compass bearings, corrected for declination, all distances are to a double- head nail in the side of the witness object unless otherwise noted.

Signed by Neil E. Hill P.S. P.C. Date January 21 2000

Surveyor's Michigan License No. 27447

FORM APPROVED BY MICHIGAN STATE BOARD OF PROFESSIONAL SURVEYORS, JAN. 28, 1971
REVISED MAY 14, 1975
REVISED JAN., 1983
REVISED OCT., 1995

1999-23

E - 00374