

LAND CORNER RECORDATION CERTIFICATE
Filing Requirement of Act 74, Mich. P.A. 1970 as Amended

For corners in

<u>Mackinac</u> (County)	Located In:	Corner Code #
1. Public Land Survey	T _____ R _____ T <u>42N</u> R <u>1E</u> T _____ R _____	<u>17</u>
2. Property Controlling in Section	S <u>13</u> T <u>42N</u> R <u>1E</u> S _____ T _____ R _____ S _____ T _____ R _____	<u>L6</u>
3. Miscellaneous Property in Sec.	S _____ T _____ R _____ S _____ T _____ R _____	
4. Lot No. _____, Recorded Plat _____		
5. Private Claims _____		

Register of Deeds Stamp & File Number

1														
2	5		5		4		3		2		1			
3														
4	7		8		9		10		11		12			
5														
6	18		17		16		15		14					
7														
8	19		20		21		22		23		24			
9														
10	30		29		28		27		26		25			
11														
12	31		32		33		34		35		36			
13														

I, Stephan J. Szyszkoski, in a field survey on L6 02/04/2010
17 10/27/2009 do hereby state
that under requirements of P.A. 74, Michigan P.A. of 1970, the corner points mentioned in lines 1 and 2
above were in conformance with regulations and rules therefore as required in the current manual of survey
instructions of the United States Department of the Interior, Bureau of Land Management or by a decree of
a Court of Law and /or that the corner points mentioned in lines 3, 4 and 5 above were in conformance with
the rules of the Michigan Board of Land Surveyors or by a Decree of a Court of Law; established, re-
established, monumented, recovered, found as expressed below:

NOTE: Not more than 2 corners, all in the same town and range, may be recorded on this certificate.

A. Description of original monument and accessories and/or subsequent restoration:

(L6) Center of Section 13. Not established in the original survey.

(I7) Corner common to Sections 14-15-22-23. 1947 - Remonumented by G.F.DeLaMater RLS, who placed a concrete monument at the corner position. 1996 - Ronald Bischer RLS found a concrete monument and made the following witnesses: 5" Balsam N41W 54.02', 3" Balsam S77W 2.13', 5" Balsam S04E 57.17', North 2625.73' concrete monument. Recorded in Book E, Page 47.

B. Description of corner evidence found and/or method applied in restoring or reestablishing corner:

(L6) Established the corner at the intersection of straight lines connecting opposite 1/4 corners.

(I7) Found a 1/2" rebar encased in a 4" concrete monument, in good condition and at record bearing and distance from the remaining 1996 witnesses. The Balsam NW is gone, The Balsam SE is standing dead, the Balsam SW is in good condition. The concrete monument at I6 is 2625.48' north. Accepted the monument as the best available evidence of the position of the original corner.


C. Description of monument for corner and accessories established to perpetuate locating the position of the corner:

(L6) Set 1"IDx36" I.pipe with 4" alum. MDNR cap. Set measuring nail with MDNR tag in the side of:
5" W.Birch N40W 4.75' mrkd "CS BT"
8" W.Birch N26E 12.75' do
5" Balsam S58E 8.2' do
9" W.Spruce S42W 15.5' do
Bearings are magnetic.

(I7) Found 1/2" rebar in 4" concrete monument. Set measuring nail with MDNR tag in the side of:
8" Balsam S85W 2.0' mrkd "S22 NBT"
7" Balsam S70E 4.9' "S23 NBT"
6" Balsam N10W 16.45' "S15 NBT"
10" Balsam S14E 16.7' "S23 NBT"
Bearings are magnetic.

Signed by Stephan J. Szyszkoski
Surveyor's Michigan License No. 33986

Date 05/20/2010

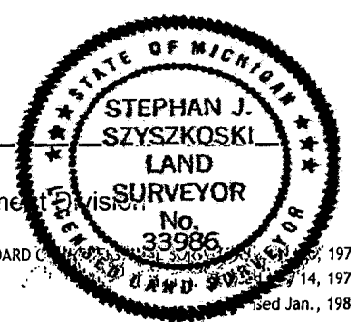

For the Michigan Department of Natural Resources and Environment, Forest Management Division

47365
47366