LAND CORNER RECORDATION CERTIFICATE

Filing Requirement of Act 74, Mich. P.A. 1970 as Amended

For corners in

Mackinac (County) Located In: Corner Code #

1. Public Land Survey T 42N R 1E I6
   T R
   T R
2. Property Controlling S T R
   in Section S T R
   S T R
3. Miscellaneous S T R
   Property in Sec. S T R

4. Lot No. _____, Recorded Plat _____
5. Private Claims

Register of Deeds Stamp & File Number

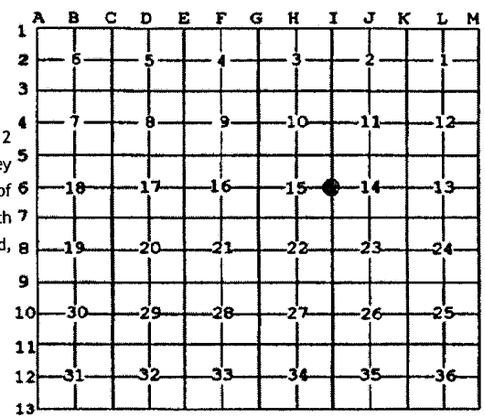

I, Stephan J. Szyszkoski, in a field survey on 02/11/2010 do hereby state that under requirements of P.A. 74, Michigan P.A. of 1970, the corner points mentioned in lines 1 and 2 above were in conformance with regulations and rules therefore as required in the current manual of survey instructions of the United States Department of the Interior, Bureau of Land Management or by a decree of a Court of Law and /or that the corner points mentioned in lines 3, 4 and 5 above were in conformance with the rules of the Michigan Board of Land Surveyors or by a Decree of a Court of Law; established, re-established, monumented, recovered, found as expressed below:

NOTE: Not more than 2 corners, all in the same town and range, may be recorded on this certificate.

A. Description of original monument and accessories and/or subsequent restoration:

(I6) Quarter corner common to Sections 14 and 15. 1947 - Corner remonumented by G.F.DeLaMater RLS who set a concrete monument at the corner position. 1996 - Ronald Bischer RLS foundd a concrete monument and made the following witnesses: 5" Aspen N72E 48.22', 3" Spruce N54E 21.65', 7" Cedar N62W 68.12', 1" pipe North 2622.73'. Recorded in Book E Page 46.

B. Description of corner evidence found and/or method applied in restoring or reestablishing corner:

(I6) Recovered a 1/2" rebar encased in a 4" concrete monument in good condition and at record bearing and distance from the Cedar NW NBT, good condition, and the Aspen NE NBT, now dead. A 1" iron pipe is North 2622.43' in agreement with the 1996 record. I note that the 1" pipe does not mark the position for corner I5, according to record for I5 found in Book E Page 371. I accept the concrete monument as the best available evidence of the position of the original corner.

C. Description of monument for corner and accessories established to perpetuate locating the position of the corner:

(I6) Found 1/2" rebar in 4" concrete monument.
Set measuring nail with MDNR tag in the side of:
12" W.Spruce N61E 21.85' mrkd "1/4S NBT"
10" W.Spruce S77E 47.6' do
9" W.Spruce S07W 50.15' do
16" Cedar N55W 68.1' mrkd "1/4S" 1996 NBT
Bearings are magnetic.

STATE OF MICHIGAN
STEPHAN J. SZYSZKOSKI
LAND SURVEYOR
No. 33986
LICENSED LAND SURVEYOR

Signed by Stephan J. Szyszkoski Date 05/20/2010

Surveyor's Michigan License No. 33986

For the Michigan Department of Natural Resources and Environment, Forest Management Division

FORM APPROVED BY MICHIGAN STATE BOARD OF PROFESSIONAL SURVEYORS, JAN. 28, 1971
Revised May 14, 1975
Revised Jan., 1983
Rervised Oct., 1995

47368