


T 42 N R 01 W JAN 21 1999  
 Clark Twp. SECTION

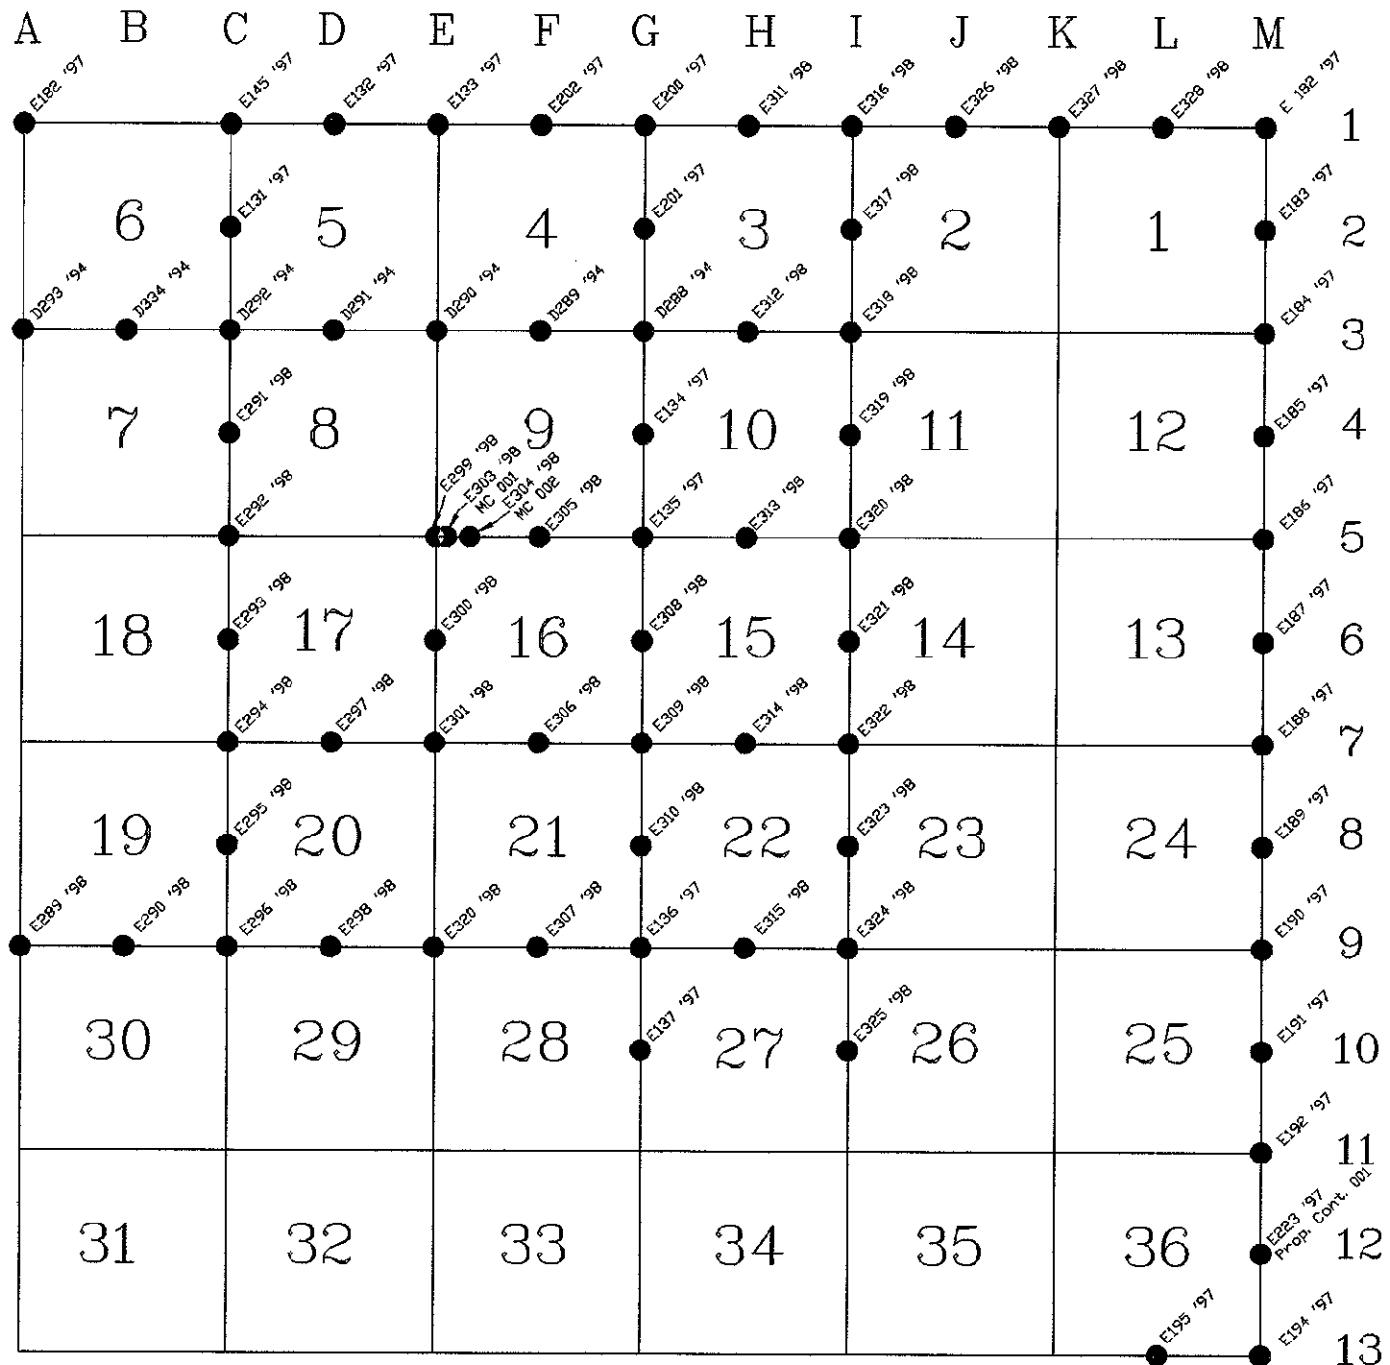

● Denotes Set ReMonumentation Corner in 1998

● Denotes Previously Set ReMonumentation Corner