

MICHIGAN
DEPARTMENT OF CONSERVATION
FORESTRY DIVISION

LAND CORNER RECORD

T. 42 NR. 1 W.


Mackinac COUNTY

DESCRIPTION OF CORNER West 1/8 corner of Section 17

DESCRIPTION OF CORNER MONUMENT 1 1/2" iron pipe

WITNESSES TO CORNER 5" W. Birch N 20° W 30 1/2 links

10" Hard Maple S 59° W 41 links
Marked "BT"
Marked "BT"

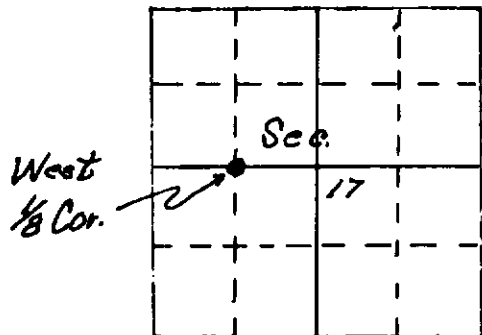

DESCRIPTION IN DETAIL AS TO HOW CORNER WAS LOCATED AND IDENTIFIED OR RESTORED.

Placed west 1/8 corner midway between center of section and west 1/4 corner of Section 17.

SURVEYORS SEAL

SIGNED Billy D. Buckler DATE 5/2/57
REGISTERED LAND SURVEYOR