

MICHIGAN  
DEPARTMENT OF CONSERVATION  
FORESTRY DIVISION

LAND CORNER RECORD

T. 42 NR. 1 W.


Mackinac COUNTY

DESCRIPTION OF CORNER Center of Section 17

DESCRIPTION OF CORNER MONUMENT 2 1/2" x 4 1/2" iron pipe

WITNESSES TO CORNER 13" Cedar South 9 links  
Marked "C S 17 BT"

6" Cedar N 55° W 39 links  
Marked "C S 17 BT"

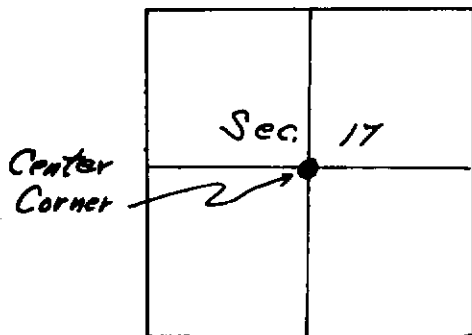

DESCRIPTION IN DETAIL AS TO HOW CORNER WAS LOCATED AND IDENTIFIED OR RESTORED.

Placed center corner at intersection of N-S and E-W 1/4 lines.

Center corner lies in swamp.

SURVEYORS SEAL

SIGNED Billy D. Buckles DATE 5/2/57  
REGISTERED LAND SURVEYOR