

MICHIGAN
DEPARTMENT OF CONSERVATION
FORESTRY DIVISION

LAND CORNER RECORD

T. 42N N. R. 1W


Mackinac COUNTY

DESCRIPTION OF CORNER Sec. Cor. common to Secs. 10-11-14-15

CORNER MONUMENT 1" pipe with 4" aluminum cap

DATE MONUMENT PLACED AND WITNESSED 5-6-70

WITNESSES TO CORNER..... 9" Cedar (S10 NBT) N82°E 24.2'

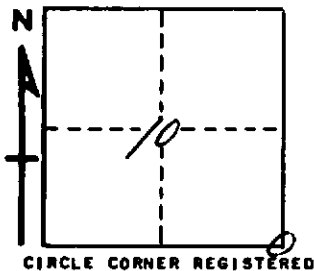

10" Cedar (S14 NBT) S36°E 6.2'

8" Cedar (S11 NBT) N27°E 8.8'

AND

DESCRIPTION IN DETAIL AS TO HOW CORNER WAS LOCATED AND IDENTIFIED OR RESTORED.

This corner replaced at a pine stub which was originally marked as a corner tree.
(Record indicates a 12" W. Pine for corner).

Found remains of blazed faces on all four sides. Pine has been cut 6' high.
Found two cedars facing the corner, both have been blazed and cut high about the
time of the early logging.

Swamp edge to North checks well (8.00 chains).

SURVEYOR'S SEAL

SIGNED Billy D. Buckler,
Billy D. Buckler DATE 8-4-70
REGISTERED LAND SURVEYOR