

SURVEY & REMONUMENTATION

APR 28 1995

COMMISSION

MACKINAC COUNTY REMONUMENTATION

LAND CORNER RECORDATION CERTIFICATE
Filing Requirement of Act 74, Mich. P.A. 1970

For corners in

<u>Mackinac</u> (County)	Located In:	Corner Code #
1. Public Land Survey	T <u>42N</u> R <u>1W</u>	<u>B-3</u>
	T _____ R _____	_____
	T _____ R _____	_____
	T _____ R _____	_____
2. Property Controlling in Section	S _____ T _____ R _____	_____
	S _____ T _____ R _____	_____
3. Miscellaneous Property in Sec.	S _____ T _____ R _____	_____
	S _____ T _____ R _____	_____
4. Lot No. _____, Recorded Plat _____		
5. Private Claims _____		

Register of Deeds Stamp & File Number

	A	B	C	D	E	F	G	H	I	J	K	L	M
2	6	5	4	3	2	1							
3	7	8	9	10	11	12							
4	18	17	16	15	14	13							
5													
6	19	20	21	22	23	24							
7													
8	30	29	28	27	26	25							
9													
10	31	32	33	34	35	36							
11													
12													
13													

I, James H. Granger in a field survey on August 9, 19 94, do hereby certify that under requirements of P.A. 74, Michigan P.A. of 1970, the corner points mentioned in lines 1 and 2 above were in conformance with regulations and rules therefore as required in the current manual of survey instructions of the United States Department of the Interior, Bureau of Land Management or by a decree of a Court of Law and/or that the corner points mentioned in lines 3, 4 and 5 above were in conformance with the rules of the Michigan Board of Land Surveyors or by a Decree of a Court of Law; established, re-established, monumented, re-monumented, recovered, found as expressed below:

NOTE: Not more than 4 corners, all in the same town and range, may be recorded on this certificate.

A. Description of original monument and accessories and/or subsequent restoration:

1845 Original Survey, Set wood post, 12" Beech S72°W 32 lks, 12" Beech N77°E 26 lks
James Mullett

B. Description of corner evidence found and/or method applied in restoring or reestablishing corner:


No evidence found. Set 5/8" rebar w/aluminum cap on line and proportionately between the SW and SE section corners based on GLO Notes.

ACCEPTED BY THE MACKINAC COUNTY SURVEY PEER GROUP AS THE OFFICIAL CORNER UNDER P.A. 345 OF 1990 AT A MEETING HELD ON 10-17-94

James H. Granger

C. Description of monument for corner and accessories established to perpetuate locating the position of the corner:

- 5/8" rebar w/aluminum cap
- 14" Maple N04°W 22.43'
- G-Cap N06°E
- Tw. 8" Maple S49°W 19.77'
- Tw. 12" Maple N72°E 59.78'

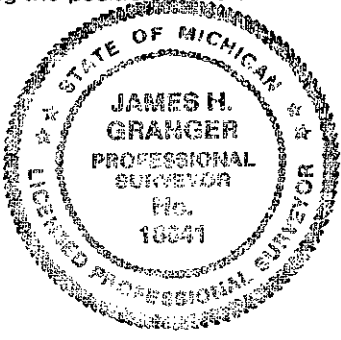

Signed by *James H. Granger* Date 11-16-94
Surveyor's Michigan License No. 16041

D-0334