SURVEY & REMONUMENTATION

OCT 1 1 1994

COMMISSION

MACKINAC COUNTY REMONUMENTATION CORNER

LAND CORNER RECORDATION CERTIFICATE

Filing Requirement of Act 74, Mich. P.A. 1970

For corners in

Mackinac (County)

	Located In:	Corner Code ##
1. Public Land Survey	T 42N R 1W	C-3
	T ___ R ___	
	T ___ R ___	
	T ___ R ___	
2. Property Controlling	S ___ T ___ R ___	
in Section	S ___ T ___ R ___	
3. Miscellaneous	S ___ T ___ R ___	
Property in Sec.	S ___ T ___ R ___	

RECEIVED & FILED
DIANE THEIS KOVICH
REGISTER OF DEEDS

SEP 6 1994

AM PM
7|8|9|10|11|12|1|2|3|4|5|6

Register of Deeds Stamp & File Number

4. Lot No. _____ , Recorded Plat _____
5. Private Claims _____

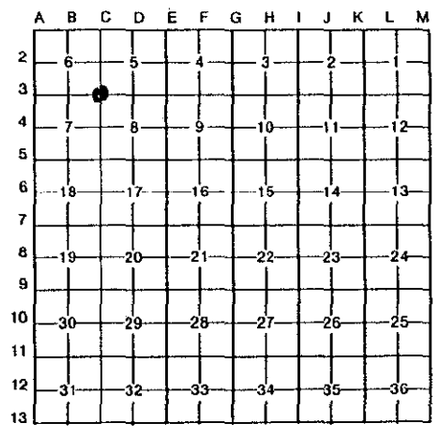

I, James H. Granger, in a field survey on August 9, 1994, do hereby certify that under requirements of P.A. 74, Michigan P.A. of 1970, the corner points mentioned *in lines 1 and 2 above were in conformance with regulations and rules therefore as required in the* current manual of survey instructions of the United States Department of the Interior, Bureau of Land Management or by a decree of a Court of Law and/or that the corner points mentioned in lines 3, 4 and 5 above were in conformance with the rules of the Michigan Board of Land Surveyors or by a Decree of a Court of Law; established, re-established, monumented, re-monumented, recovered, found as expressed below:

NOTE: Not more than 4 corners, all in the same town and range, may be recorded on this certificate.

A. Description of original monument and accessories and/or subsequent restoration:

1845 Original survey — set wood post
James Mullett — 8" beech N22°E 91ks.
12" beech S67°W 311ks.

1969 Survey — no indication of monument
Kenneth Larsen
#10695

1987 Survey — found 1" pipe
William Karr #27450

B. Description of corner evidence found and/or method applied in restoring or reestablishing corner:

Found 1" pipe and 8" red maple witness tree cut down and 1 other witness.

ACCEPTED BY THE MACKINAC COUNTY SURVEY PEER GROUP AS THE OFFICIAL CORNER UNDER P.A. 345 OF 1990 AT A MEETING HELDON 8-16-94
James H. Granger

09-06-94

C. Description of monument for corner and accessories established to perpetuate locating the position of the corner:

Set 5/8" rerod w/alum. cap

1" iron bolt	S 2°E	15.37'	
8" ash	N42°W	79.27'	tag #16041
12" sugar maple	S41°E	45.34'	tag #16041
5" ironwood	N59°E	85.95'	tag #16041
USFS elev. mon.	S45°E	45.88'	

STATE OF MICHIGAN
JAMES H. GRANGER
PROFESSIONAL SURVEYOR
No. 16041
LICENSED PROFESSIONAL SURVEYOR

Signed by James H. Granger Date August 30, 1994

Surveyor's Michigan License No. 16041 09-06-94

FORM APPROVED BY MICHIGAN STATE BOARD OF LAND SURVEYORS, JAN. 28, 1971
REVISED MAY 14, 1975
REVISED JAN., 1983

D-0292