

SECTION

Property in Sec.

Lot No. 5. Private Claims

LAND CORNER RECORDATION CERTIFICATE Filing Requirement of Act 74, Mich. P.A. 1970

Mackinac County Remonumentation Corner

For corners in Mackinac County Located in: Corner Code # T42N R01W 1. Public Land Survey Т R Ţ R R Τ T R 2. Property Controlling S S T R in Section S R 3. Miscellaneous

S

, Recorded Plat

BECEIVED 8 DIANE FRANKCYICH MACRIMAC CORINTY RECIET. OF DELDS


Register of Deeds Stamp & File Number

DEC 3 1 1998 25% 11/1 7181913812142414213141516


I, Neil E. Hill, in a field survey on 12-21-95, do hereby state that under requirements of P.A. 74, Michigan P.A. of 1970, the corner points mentioned in lines 1 and 2 above were in conformance with regulations and rules therefore as required in the current manual of survey instructions of the United States Department of the Interior, Bureau of Land Management or by a decree of a Court of Law and /or that the corner points mentioned in lines 3, 4 and 5 above were in conformance with the rules of the Michigan Board of Land Surveyors or by a Decree of a Court of Law;

NOTE: Not more than 2 corners, all in the same town and range, may be recorded on this certificate.

established, re-established, monumented, recovered, found as expressed below:

 

1845 GLO Notes J Mullett	20" W Pine	N 47 W	35 lks
	18" W Pine	S 34 E	18 lks
1956 DNR Billy Buckler Set 1" pipe with brass cap from 2 Pine stumps along 4" Sq conc mon Liber 2, Page 302	18" Hemlock	N 06 W	40 lks
	14" Hemlock	S 11 E	50 lks

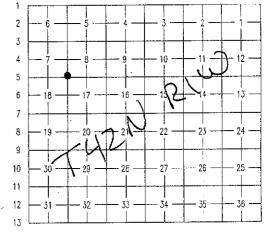

ACCEPTED BY THE MACKINAC COUNTY SURVEY PEER GROUP AS THE OFFICIAL CORNER UNDER PA. 345 OF 1990 AT A MEETING HELD ON_ 12-04-98

- B. Description of corner evidence found and/or method applied in restoring or reestablishing corner:
 - 1998 Fd 1" pipe with brass cap alongside 4" Sq conc mon and 2 witnesses Accepted corner location
- C. Description of monument for corner and accessories established to perpetuate locating the position of the corner:

Corner is a 1" pipe with 4" brass DNR cap Corner is along woods line approx 20' East of Power line

10" Hemlock	N 05 W	22.13'
12" Hemlock	N 20 E	19.77'
10" W Birch	N 80 E	11.84
18" Maple	N 50 W	48.45'



Bearings are compass bearings, corrected for declination, all distances are to a double-headed nail in the side of the witness object unless otherwise noted.

Pis,

12-29-98 Date

Surveyor's Michigan License No. 27447