JAN 21 1999

SECTION

LAND CORNER RECORDATION CERTIFICATE Filing Requirement of Act 74, Mich. P.A. 1970

Mackinac County Remonumentation Corner

For corners in				
Mackinac County	Located	in:		Corner Code #
Public Land Survey		T42N T T T	R01W R R R	C-7
Property Controlling in Section	S S	T T	R R	
Miscellaneous Property in Sec.	S S	T T	R R	

acceived a DIANE FRANKOVICH MACRIMAC COUNTY BEGINTH OF DEEDS

DEC 31 1998

PIA 118161161111112111215141516

Register of Deeds Stamp & File Number


4. Lot No.

, Recorded Plat


5. Private Claims

I, Neil E. Hill, in a field survey on 12-21-98, do hereby state that under requirements of P.A. 74, Michigan P.A. of 1970, the corner points mentioned in lines 1 and 2 above were in conformance with regulations and rules therefore as required in the current manual of survey instructions of the United States Department of the Interior, Bureau of Land Management or by a decree of a Court of Law and /or that the corner points mentioned in lines 3, 4 and 5 above were in conformance with the rules of the Michigan Board of Land Surveyors or by a Decree of a Court of Law; established, re-established, monumented, recovered, found as expressed below:

NOTE: Not more than 2 corners, all in the same town and range, may be recorded on this certificate.

 

1845	GLO Notes J Mullett	12" W pine 6" Aspen	N 38 W S 21 E	13 lks 16 lks
1957	DNR Billy Buckler Set 1" Pipe and 4" brass cap from burned BTs Liber 2, Page 298	15" R Pine 8" W Pine	S 17 W N 52 E	115 lks 59 lks

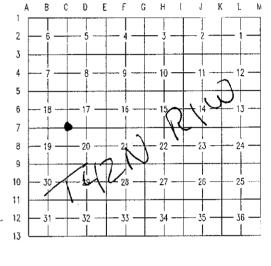

ACCEPTED BY THE MACKINAC COUNTY SURVEY PEER GROUP AS THE OFFICIAL CORNER UNDER PA. 345 OF 1990 AT A MEETING 12-04-90 NEH HELD ON

- B. Description of corner evidence found and/or method applied in restoring or reestablishing corner:
 - 1998 Fd 1" Pipe and DNR cap and 1 witness Fd stump of original BT (W Pine OBT N 38 W 8.58') Accepted corner location



· C. Description of monument for corner and accessories established to perpetuate locating the position of the corner:

Corner is 1" pipe with 4" brass DNR cap Corner lies on the South edge of old E-W logging RR grade (Grade runs along the East mile of line)

14" W Birch	S 70 E	15.33
12" Poplar	S 10 W	7.00
8" Spruce	N 15 W	9.73
12" Norway	N 65 E	20.63

Bearings are compass bearings, corrected for declination, all distances are to a double-headed nail in the side of the witness object unless otherwise noted.

₽**≥′ 12-29-98 Date

Surveyor's Michigan License No. 27447