SURVEY & REMONUMENTATION

JAN 21 1999

SECTION

LAND CORNER RECORDATION CERTIFICATE Filing Requirement of Act 74, Mich. P.A. 1970

Mackinac County Remonumentation Corner

For corners in

Mackinac County Located in: Corner Code # T42N R01W 1. Public Land Survey C-8 T R T R Т R Т R 2. Property Controlling S in Section S Ţ R R S Miscellaneous Property in Sec.

DIAME FRANKOVICH MACKINAC COUNTY OFCISTE OF BEEDS

DEC S 1 1998

13:14

Register of Deeds Stamp & File Number


4. Lot No.

, Recorded Plat


5. Private Claims

1. Neil E. Hill, in a field survey on 12-21-98, do hereby state that under requirements of P.A. 74, Michigan P.A. of 1970, the corner points mentioned in lines 1 and 2 above were in conformance with regulations and rules therefore as required in the current manual of survey instructions of the United States Department of the Interior, Bureau of Land Management or by a decree of a Court of Law and for that the corner points mentioned in lines 3, 4 and 5 above were in conformance with the rules of the Michigan Board of Land Surveyors or by a Decree of a Court of Law; established, re-established, monumented, recovered, found as expressed below:

NOTE: Not more than 2 corners, all in the same town and range, may be recorded on this certificate.

 

1845 GLO Notes J Mullett	10" Aspen	S 65 E	11 lks
	12" Tamarack	N 51 W	19 lks
1994 R Bischer Fd 1 ½" pipe and 2 posts Old fences running E-W Liber D, Page 248	10" Cedar	Due S	30.90'
	16" Cedar	S 71 E	29.90'
	6" Birch	N 20 W	28.20'

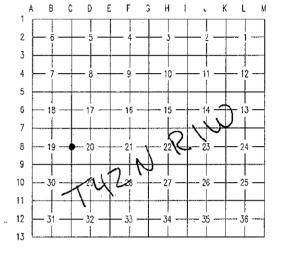

ACCEPTED BY THE MACKINAC COUNTY SURVEY PEER GROUP AS THE OFFICIAL CORNER UNDER PA. 345 OF 1990 AT A MEETING HELD ON 12-11-9 このこ

B. Description of comer evidence found and/or method applied in restoring or reestablishing corner:

1998 Fd1 1/2" pipe and 1 witness Accepted corner location Placed 4" Alum. remonumentation cap

C. Description of monument for corner and accessories established to perpetuate locating the position of the corner:

Corner is a 1 1/2" pipe with 4" Alum. remonumentation cap Corner is approx 180' East of gravel 2 track in a wet area

10" Cedar	Due S	30.90
16" Cedar	S 71 E	29.90
6" Birch	N 20 W	28.20
4" Birch	N 40 W	7.03

(Old single washer witness same side of tree)

Date



Bearings are compass bearings, corrected for declination, all distances are to a double-headed nail in the side of the witness object unless otherwise noted.

12-29-98

Surveyor's Michigan License No. 27447