

SURVEY & REMONUMENTATION

APR 0 8 1998

1997 Mackinac County Remonumentation Corner
LAND CORNER RECORDATION CERTIFICATE
Filing Requirement of Act 74, Mich. P.A. 1970

For corners in SECTION

| | | | |
|--|-------------------|---------------|--|
| <u>Mackinac</u> <small>(County)</small> | Located In: | Corner Code # | |
| 1. Public Land Survey | T42N R 1W | D-1 ✓ | |
| | T43N R 1W | D-13 | |
| | T ___ R ___ | | |
| | T ___ R ___ | | |
| 2. Property Controlling in Section | S ___ T ___ R ___ | | |
| | S ___ T ___ R ___ | | |
| 3. Miscellaneous Property in Sec. | S ___ T ___ R ___ | | |
| | S ___ T ___ R ___ | | |

RECEIVED & FILED
DIANE FRANKOVICH
MACKINAC COUNTY REGISTER OF DEEDS

DEC 18 1997
AM _____ PM _____
7|8|9|10|11|12|1|2|3|4|5|6

Register of Deeds Stamp & File Number

4. Lot No. _____, Recorded Plat _____
5. Private Claims _____

| | | | | | | | | | | | | | |
|----|----|---|---|----|---|---|----|---|---|----|---|---|----|
| | A | B | C | D | E | F | G | H | I | J | K | L | I |
| 1 | | | | | | | | | | | | | |
| 2 | 6 | | | 5 | | | 4 | | | 3 | | | 2 |
| 3 | | | | | | | | | | | | | |
| 4 | 7 | | | 8 | | | 9 | | | 10 | | | 11 |
| 5 | | | | | | | | | | | | | |
| 6 | 18 | | | 17 | | | 16 | | | 15 | | | 14 |
| 7 | | | | | | | | | | | | | |
| 8 | 19 | | | 20 | | | 21 | | | 22 | | | 23 |
| 9 | | | | | | | | | | | | | |
| 10 | 30 | | | 29 | | | 28 | | | 27 | | | 26 |
| 11 | | | | | | | | | | | | | |
| 12 | 31 | | | 32 | | | 33 | | | 34 | | | 35 |
| 13 | | | | | | | | | | | | | |

I, David B. Guthrie, in a field survey on July 18, 1997 do hereby state that under requirements of P.A. 74, Michigan P.A. of 1970, the corner points mentioned in lines 1 and 2 above were in conformance with regulations and rules therefore as required in the current manual of survey instructions of the United States Department of the Interior, Bureau of Land Management or by a decree of a Court of Law and/or that the corner points mentioned in lines 3, 4 and 5 above were in conformance with the rules of the Michigan Board of Land Surveyors or by a Decree of a Court of Law; established, re-established, monumented, recovered, found as expressed below:

NOTE: Not more than 2 corners, all in the same town and range, may be recorded on this certificate.

- A. Description of original monument and accessories and/or subsequent restoration:
- 1840: G.L.O. Survey by Wm. Burt - Set Post and Referenced -
Sugar 14 / N52E / 21
Sugar 12 / N15W / 23
 - 1986: Survey by Wm. Karr - Found 3/4" Iron Pipe.
Referenced -
Penceline to North-East - 56'
Road C.L. N-S - 5'
Certificate of Survey Recorded in L. 293, P. 342.


- B. Description of corner evidence found and/or method applied in restoring or reestablishing corner:
- 1997 Remonumentation Survey by R.S. Scott Associates, Inc.
Found 3/4" Iron Pipe 6' South of Road C.L.
Referenced -
(Exist.) S05°E - 6" Maple - 10.55'
(Exist.) S69°W - 6" Maple - 26.92'
N35°W - 12" Maple - 40.48'
N05°E - 4" Ironwood - 23.96'

This corner position is compatible with County and local surveys. This corner position is accepted as a careful and faithful perpetuation of the position of the original corner.

- C. Description of monument for corner and accessories established to perpetuate locating the position of the corner:

- 1997: Placed 3" Mackinac County Cap stamped to identify the corner over the 1/2" Iron Rod.
Referenced -
(Exist.) S05°E - 6" Maple - 10.55'
(Exist.) S69°W - 6" Maple - 26.92'
N35°W - 12" Maple - 40.48'
N05°E - 4" Ironwood - 23.96'

ACCEPTED BY THE MACKINAC COUNTY SURVEY PEER GROUP AS THE OFFICIAL CORNER UNDER P.A. 345 OF 1990 AT A MEETING HELD ON 11-21-97

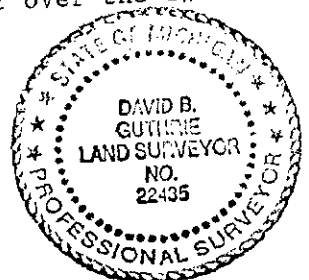

Signed by David B. Guthrie

Date 12-12-97