

SURVEY & REMONUMENTATION

OCT 1 1 1994

**MACKINAC COUNTY REMONUMENTATION CORNER
LAND CORNER RECORDATION CERTIFICATE
Filing Requirement of Act 74, Mich. P.A. 1970**

COMMISSION

For corners in

Mackinac

(County)

Located In:

Corner Code =#

- | | | |
|---------------------------------------|--------------------------|------------|
| 1. Public Land Survey | T <u>42N</u> R <u>1W</u> | <u>D-3</u> |
| | T _____ R _____ | _____ |
| | T _____ R _____ | _____ |
| | T _____ R _____ | _____ |
| 2. Property Controlling in Section | S _____ T _____ R _____ | _____ |
| | S _____ T _____ R _____ | _____ |
| 3. Miscellaneous Property in Sec. | S _____ T _____ R _____ | _____ |
| | S _____ T _____ R _____ | _____ |
| 4. Lot No. _____, Recorded Plat _____ | | |
| 5. Private Claims _____ | | |

RECEIVED & FILED
DEPT. OF STATE
MACKINAC COUNTY, MICHIGAN

SEP 6 1994
AM PM
7[8][9][10][11][12][13][14][15][16]

Register of Deeds Stamp & File Number

I, James H. Granger, in a field survey on August 9, 19 94, do hereby certify that under requirements of P.A. 74, Michigan P.A. of 1970, the corner points mentioned in lines 1 and 2 above were in conformance with regulations and rules therefore as required in the current manual of survey instructions of the United States Department of the Interior, Bureau of Land Management or by a decree of a Court of Law and/or that the corner points mentioned in lines 3, 4 and 5 above were in conformance with the rules of the Michigan Board of Land Surveyors or by a Decree of a Court of Law; established, re-established, monumented, re-monumented, recovered, found as expressed below:

NOTE: Not more than 4 corners, all in the same town and range, may be recorded on this certificate.

	A	B	C	D	E	F	G	H	I	J	K	L	M
2	6		5		4		3		2		1		
3			●										
4	7		8		9		10		11		12		
5													
6	18		17		16		15		14		13		
7													
8	19		20		21		22		23		24		
9													
10	30		29		28		27		26		25		
11													
12	31		32		33		34		35		36		
13													

A. Description of original monument and accessories and/or subsequent restoration:

- 1845 original survey corner was 10" beech
James mullett
- 1982 survey found 3/4" iron pipe
William Karr #27450
- 1990 survey found 3/4" iron pipe
Thomas Fabis #31591

B. Description of corner evidence found and/or method applied in restoring or reestablishing corner:


found 3/4" iron pipe and 2 witnesses.

ACCEPTED BY THE MACKINAC COUNTY SURVEY PEER GROUP AS THE OFFICIAL CORNER UNDER P.A. 345 OF 1990 AT A MEETING HELD ON 8-16-94

James H. Granger

C. Description of monument for corner and accessories established to perpetuate locating the position of the corner:

- set 5/8" rerod w/alum. cap
- 16" ash N 5°W 27.50' tag #22428
- 7" maple N55°E 38.20' tag #22428
- 6" birch S10°W 90.89' tag #16041
- 6" ironwood S42°E 79.01' tag #16041

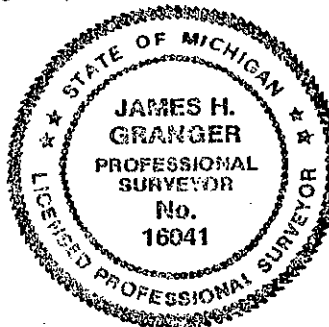

Signed by James H. Granger Date August 30, 1994
Surveyor's Michigan License No. 16041

09-04-94 FORM APPROVED BY MICHIGAN STATE BOARD OF LAND SURVEYORS, JAN. 28, 1971
REVISED MAY 14, 1975
REVISED JAN., 1983

D-0291

09-06-94
CLT:R
6-9-94