MAR 2 0 2000

LAND CORNER RECORDATION CERTIFICATE Filing Requirement of Act 74, Mich. P.A. 1970

SECTION

Mackinac County Remonumentation Corner

For corners in

Mackinac County	Located in:			Corner Code #
 Public Land Survey Property Controlling in Section Miscellaneous Property in Sec. 	SSSS	T42N T T T T T T	R01W R R R R R R R R	D-5

RECEIVED & FILED DIANE FRANKOVICH MACKINAC COUNTY REGISTE: OF DEEDS FEB 2 5 2000 AM 7[8]9[10]11[12]1[2]3]4[5]6

Register of Deeds Stamp & File Number


4. Lot No.

. Recorded Plat


5. Private Claims

I, Neil E. Hill, in a field survey on 12-20-99, do hereby state that under requirements of P.A. 74, Michigan P.A. of 1970, the corner points mentioned in lines 1 and 2 above were in conformance with regulations and rules therefore as required in the current manual of survey instructions of the United States Department of the Interior, Bureau of Land Management or by a decree of a Court of Law and /or that the corner points mentioned in lines 3, 4 and 5 above were in conformance with the rules of the Michigan Board of Land Surveyors or by a Decree of a Court of Law; established, re-established, monumented, recovered, found as expressed below:

NOTE: Not more than 2 corners, all in the same town and range, may be recorded on this certificate.

 

1845 GLO Notes J Mullett 10" Spruce for 1/4 Post 1957 DNR Billy Buckler 8" Cedar S 48 W 57 lks Set 1" pipe with brass cap 6" Cedar S 50 E 62 lks midway and online Recorded DNR Book 1 Page 301

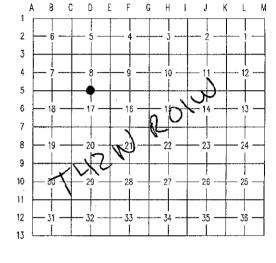

ACCEPTED BY THE MACKINAC COUNTY SURVEY PEER GROUP AS THE OFFICIAL CORNER UNDER P.A. **345 OF 1990 AT A MEETING** HELD ON 11-05-90


No Subsequent Information

- B. Description of corner evidence found and/or method applied in restoring or reestablishing corner:
 - 1999 Fd standard DNR Monument 1" pipe with brass cap and marking post Accepted corner location
- C. Description of monument for corner and accessories established to perpetuate locating the position of the corner:

Corner is a 1" pipe with brass DNR cap

There has been a clear cut North and East of corner location

8" Cedar S 85 W 3.98 8" Cedar N 25 W 4.94 6" Cedar S 30 W 22.20' 6" Spruce S 25 W 13.86



Bearings are compass bearings, corrected for declination, all distances are to a double- head nail in the side of the witness object unless otherwise noted.

Date

dill PS,PC. Signed by

January 21 2000

Surveyor's Michigan License No. 27447