

LAND CORNER RECORDATION CERTIFICATE Filing Requirement of Act 74, Mich. P.A. 1970

MAR 2 0 2000

SECTION

Mackinac County Remonumentation Corner

For corners in

Mackinac County Located in: Corner Code # 1. Public Land Survey T42N R01W E-2 Т R Т R Τ R 2. Property Controlling S T R in Section S Т R Miscellaneous S T R Property in Sec. S

FEB 2 5 2000

DIANE FRANKO

PM AM 71819110111112111213141516

MACKINAC COUNTY REGISTE OF DEEDS

Register of Deeds Stamp & File Number


4. Lot No.

, Recorded Plat

5. Private Claims


I, Neil E. Hill, in a field survey on 12-20-99, do hereby state that under requirements of P.A. 74, Michigan P.A. of 1970, the corner points mentioned in lines 1 and 2 above were in conformance with regulations and rules therefore as required in the current manual of survey instructions of the United States Department of the Interior, Bureau of Land Management or by a decree of a Court of Law and /or that the corner points mentioned in lines 3, 4 and 5 above were in conformance with the rules of the Michigan Board of Land Surveyors or by a Decree of a Court of Law; established, re-established, monumented, recovered, found as expressed below:

NOTE: Not more than 2 corners, all in the same town and range, may be recorded on this certificate.

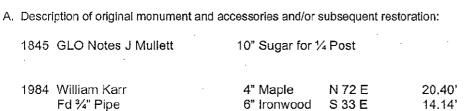

No Subsequent Information

Accepted corner location Liber C Page 043

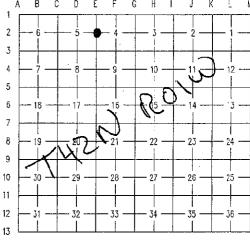

ACCEPTED BY THE MACKINAC COUNTY SURVEY PEER GROUP AS THE OFRCIAL CORNER UNDER P.A. 345 OF 1990 AT A MEETING HELD ON

B. Description of corner evidence found and/or method applied in restoring or reestablishing corner:

10" Maple

8" Maple

S 26 W

N 34 W

5.69

7.87

1999 Fd Corner and 2 witnesses Accepted corner location

Placed 4" Alum. remonumentation cap

C. Description of monument for corner and accessories established to perpetuate locating the position of the corner

Corner is a 3/4" pipe with 4" Alum. remonumentation cap Corner is on the west side of a N-S trail, approx 20' South of an E-W trail

11" Maple	S 25 W	5.62'
9" Maple	N 35 W	7.91
8" Maple	S 40 E	23.50'
16" Maple	N 20 E	46.801



Bearings are compass bearings, corrected for declination, all distances are to a double- head nail in the side of the witness object unless otherwise noted.

Date

will R.S. RC

January 21 2000

Surveyor's Michigan License No. 27447

FORM APPROVED BY MICHIGAN STATE BOARD OF PROFESSIONAL SURVEYORS, JAN. 28, 1971
REVISED MAY 14, 1975

REVISED JAN., 1983 REVISED OCT., 1995