

OCT 11 1994

COMMISSION

MACKINAC COUNTY REMONUMENTATION CORNER
LAND CORNER RECORDATION CERTIFICATE
Filing Requirement of Act 74, Mich. P.A. 1970

For corners in

Mackinac
(County)

Located In:

Corner Code #/

- 1. Public Land Survey T 42N R 1W E-3
- T _____ R _____
- T _____ R _____
- T _____ R _____
- T _____ R _____
- 2. Property Controlling S _____ T _____ R _____
- in Section S _____ T _____ R _____
- 3. Miscellaneous S _____ T _____ R _____
- Property in Sec. S _____ T _____ R _____


RECEIVED & FILED
DIANE FRALICHON
MACKINAC COUNTY REGISTER OF DEEDS

SEP 6 1994

AM 2:18 PM 10/11/94-1413141516

Register of Deeds Stamp & File Number

- 4. Lot No. _____, Recorded Plat _____
- 5. Private Claims _____

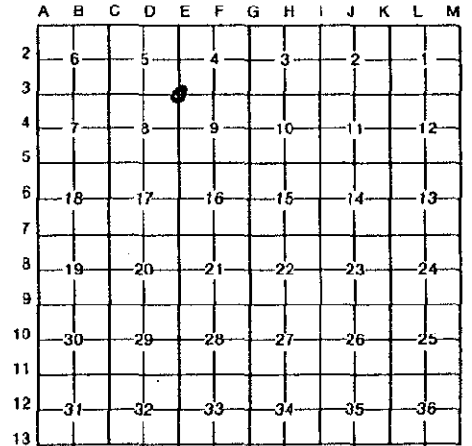

I, James H. Granger, in a field survey on August 9, 19 94, do hereby certify that under requirements of P.A. 74, Michigan P.A. of 1970, the corner points mentioned in lines 1 and 2 above were in conformance with regulations and rules therefor as required in the current manual of survey instructions of the United States Department of the Interior, Bureau of Land Management or by a decree of a Court of Law and/or that the corner points mentioned in lines 3, 4 and 5 above were in conformance with the rules of the Michigan Board of Land Surveyors or by a Decree of a Court of Law; established, re-established, monumented, re-monumented, recovered, found as expressed below:

NOTE: Not more than 4 corners, all in the same town and range, may be recorded on this certificate.

A. Description of original monument and accessories and/or subsequent restoration:

- 1845 original survey set wood post
- James Mullett 12" beech N53°E 341ks.
- 24" sugar S49°W 181ks.
- 1982 survey found 3/4" iron pipe
- William Karr #27450
- 1990 survey found 3/4" iron pipe
- Thomas Fabis #31591

B. Description of corner evidence found and/or method applied in restoring or reestablishing corner:


found 3/4" iron pipe and 3 witnesses

ACCEPTED BY THE MACKINAC COUNTY SURVEY PEER GROUP AS THE OFFICIAL CORNER UNDER P.A. 345 OF 1990 AT A MEETING HELDON 8-16-94

James H. Granger

C. Description of monument for corner and accessories established to perpetuate locating the position of the corner:

- set 5/8" rerod w/alum. cap
- P.P. S60°E 90.31' p.k. nail
- 1/2" rebar N 4°E 33.00'
- 18" maple S32°W 20.77' tag #16041
- 10" maple N35°W 38.91' tag #16041

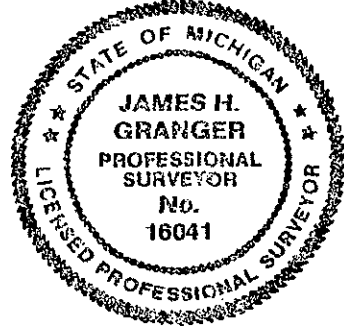

Signed by James H. Granger Date August 30, 1994

Surveyor's Michigan License No. 16041

D-0230