

SURVEY & REMONUMENTATION

MAR 13 1998

SECTION

1997 Mackinac County Remonumentation Corner
LAND CORNER RECORDATION CERTIFICATE
 Filing Requirement of Act 74, Mich. P.A. 1970

For corners in

<u>Mackinac</u> (County)	Located In:	Corner Code #
1. Public Land Survey	T <u>42</u> N R <u>1W</u>	<u>G-2</u>
	T ___ R ___	_____
	T ___ R ___	_____
	T ___ R ___	_____
2. Property Controlling in Section	S ___ T ___ R ___	_____
	S ___ T ___ R ___	_____
3. Miscellaneous Property in Sec.	S ___ T ___ R ___	_____
	S ___ T ___ R ___	_____

RECEIVED & FILED
 DIANE J. W. KOUCH
 REGISTER OF DEEDS
 DEC 31 1997
 AAI

Register of Deeds Stamp & File Number

4. Lot No. _____, Recorded Plat _____
 5. Private Claims _____

I, David B. Guthrie, in a field survey on July 18, 1997 do hereby state that under requirements of P.A. 74, Michigan P.A. of 1970, the corner points mentioned in lines 1 and 2 above were in conformance with regulations and rules therefore as required in the current manual of survey instructions of the United States Department of the Interior, Bureau of Land Management or by a decree of a Court of Law and /or that the corner points mentioned in lines 3, 4 and 5 above were in conformance with the rules of the Michigan Board of Land Surveyors or by a Decree of a Court of Law; established, re-established, monumented, recovered, found as expressed below:

NOTE: Not more than 2 corners, all in the same town and range, may be recorded on this certificate.

	A	B	C	D	E	F	G	H	I	J	K	L	M
1													
2		6		5		4	●	3		2		1	
3													
4		7		8		9		10		11		12	
5													
6		18		17		16		15		14		13	
7													
8		19		20		21		22		23		24	
9													
10		30		29		28		27		26		25	
11													
12		31		32		33		34		35		36	
13													

- A. Description of original monument and accessories and/or subsequent restoration:
 1845: G.L.O. Survey by J.H. Mullett - Set Post and Referenced -
 Hemlock 36 / N32W / 09
 Birch 12 / N78E / 08
 1982: Survey by Wm. L. Karr - Set 1/2" Rod by single proportion.
 Referenced -
 N16°46'07"W - Pin with worn Cap - 27.84' S73°E - 8" Maple - 34.11'
 N00°39'45"W - 1" Drift Pin - 142.74'
 N56°W - 8" Maple - 37.29'
 N44°E - 6" Maple - 57.77'


(CONT'D ON OTHER SIDE)

- B. Description of corner evidence found and/or method applied in restoring or reestablishing corner:
 1997: Remonumentation Survey by R.S. Scott Associates, Inc.
 Found 1/2" Iron Rod 3' E. of Rd. C.L.
 Referenced -
 (Exist.) S63°E - 8" Maple - 34.18'
 S27°W - 24" Birch - 37.12'
 (Exist.) N50°W - 16" Beech - 86.36'
 N83°E - 18" Maple - 40.75'

ACCEPTED BY THE MACKINAC COUNTY
 SURVEY PEER GROUP AS THE
 OFFICIAL CORNER UNDER P.A.
 345 OF 1990 AT A MEETING
 HELD ON 11-21-97

This corner position is compatible with County and local surveys. This corner position is accepted as a careful and faithful perpetuation of the position of the original corner.

- C. Description of monument for corner and accessories established to perpetuate locating the position of the corner:
 1997: Placed 3" Mackinac County Cap stamped to identify the corner, over 1/2" Iron Rod in Monument Box.
 Referenced -
 (Exist.) S63°E - 8" Maple - 34.18'
 S27°W - 24" Birch - 37.12'
 (Exist.) N50°W - 16" Beech - 86.36'
 N83°E - 18" Maple - 40.75'

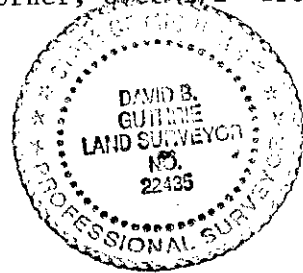

Signed by David B. Guthrie
 Surveyor's Michigan License No. 22435

Date 12-19-97