

SURVEY & REMONUMENTATION

MAR 13 1998

1997 Mackinac County Remonumentation Corner
LAND CORNER RECORDATION CERTIFICATE
 Filing Requirement of Act 74, Mich. P.A. 1970

For corners in **SECTION**
Mackinac
 (County)

Located In:


Corner Code #

- | | | |
|--------------------------------------|--------------------------|------------|
| 1. Public Land Survey | T <u>42N</u> R <u>1W</u> | <u>G-4</u> |
| | T _____ R _____ | _____ |
| | T _____ R _____ | _____ |
| | T _____ R _____ | _____ |
| 2. Property Controlling in Section | S _____ T _____ R _____ | _____ |
| | S _____ T _____ R _____ | _____ |
| 3. Miscellaneous Property in Section | S _____ T _____ R _____ | _____ |
| | S _____ T _____ R _____ | _____ |

RECEIVED & FILED
 DIANE FRANKOVICH
 MACKINAC COUNTY REGISTER OF DEEDS

DEC 18 1997
 AM _____ PM _____
 7/8/97 10:14:14 AM 12/18/97
Register of Deeds Stamp & File Number

4. Lot No. _____, Recorded Plat _____
 5. Private Claims _____

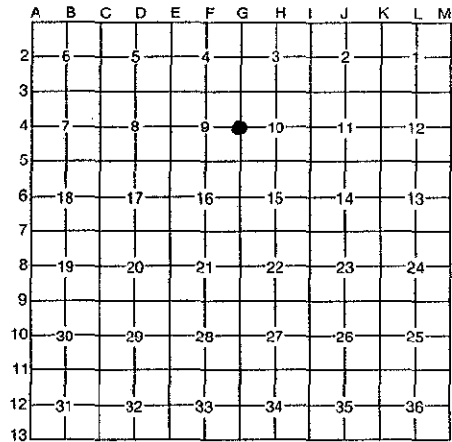

I, David B. Guthrie, in a field survey on July 8, 1997, do hereby certify that under requirements of P.A. 74, Michigan P.A. of 1970, the corner points mentioned in lines 1 and 2 above were in conformance with regulations and rules therefore as required in the current manual of survey instructions of the United States Department of the Interior, Bureau of Land Management or by a decree of a Court of Law and/or that the corner points mentioned in lines 3, 4 and 5 above were in conformance with the rules of the Michigan Board of Professional Surveyors or by a Decree of a Court of Law; established, re-established, monumented, re-monumented, recovered, found as expressed below:

NOTE: Not more than 4 corners, all in the same town and range, may be recorded on this certificate.

A. Description of original monument and accessories and/or subsequent restoration:

- 1845: G.L.O. Survey by J.H. Mullett - Set Post and Referenced - Sugar 20 / S28W / 11
 Sugar 10 / N82E / 09
- 1988: Survey by Ronald Bischer - Set 1/2" Rod by single proportion.
 Referenced - S69°W - 16" Ash - 57.25'
 N54°W - 5" Maple - 47.95'
 S76°E - Power Pole - 64.25'
- 1989: Survey by Ronald Bischer - 1/2" Rod
 Referenced - S69°W - 16" Ash - 57.25'
 N54°W - 5" Maple - 47.95'
 S76°E - Power Pole - 64.25' (CONT'D ON OTHER SIDE)

B. Description of corner evidence found and/or method applied in restoring or reestablishing corner:

- 1997: Remonumentation Survey by R.S. Scott Associates, Inc.
 Found 1/2" Iron Rod 1.3' East of road C.L.
 Referenced -
 (Exist.) N50°W - 8" Maple - 48.00'
 S70°W - Anchor Pole - 46.49'
 S71°E - Utility Pole - 62.10'
 S55°E - Twin 12" Maple - 123.86'

APPROVED BY THE MACKINAC COUNTY
 SURVEY PEER GROUP AS THE
 OFFICIAL CORNER UNDER P.A.
 345 OF 1990 AT A MEETING
 HELD ON 11-21-97

This corner position is compatible with County and local surveys. This corner position is accepted as a careful and faithful perpetuation of the original corner.

C. Description of monument for corner and accessories established to perpetuate locating the position of the corner:

- 1997: Placed 3" Mackinac County Cap stamped to identify the corner over 1/2" Iron Rod in Monument Box.
 Referenced -
 (Exist.) N50°W - 8" Maple - 48.00'
 S70°W - Anchor Pole - 46.49'
 S71°E - Utility Pole - 62.10'
 S55°E - Twin 12" Maple - 123.86'



Signed by David B. Guthrie

Date 12-12-97

Surveyor's Michigan License No. 22435