SURVEY &
REMONUMENTATION

JAN 21 1999

SECTION

LAND CORNER RECORDATION CERTIFICATE
Filing Requirement of Act 74, Mich. P.A. 1970
Mackinac County Remonumentation Corner

RECEIVED & FILED
DIANE FRANKOVICH
MACKINAC COUNTY REGISTER OF DEEDS

DEC 31 1998

AM PM
7|8|9|10|11|12|1|2|3|4|5|6

Register of Deeds Stamp & File Number

For corners in

Mackinac County	Located in:			Corner Code #
1. Public Land Survey		T42N	R01W	G-7
		T	R	
		T	R	
		T	R	
2. Property Controlling	S	T	R	
in Section	S	T	R	
3. Miscellaneous	S	T	R	
Property in Sec.	S	T	R	

4. Lot No. , Recorded Plat
5. Private Claims

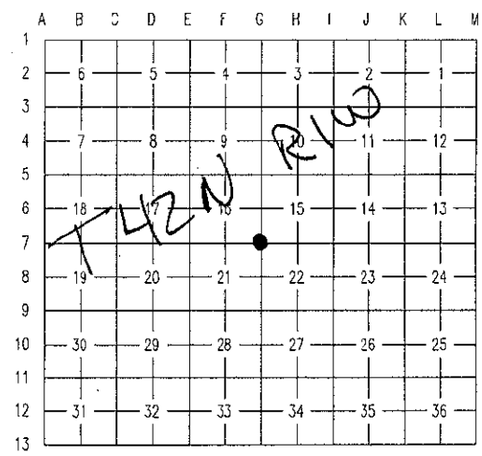

I, Neil E. Hill, in a field survey on 12-21-98, do hereby state that under requirements of P.A. 74, Michigan P.A. of 1970, the corner points mentioned in lines 1 and 2 above were in conformance with regulations and rules therefore as required in the current manual of survey instructions of the United States Department of the Interior, Bureau of Land Management or by a decree of a Court of Law and /or that the corner points mentioned in lines 3, 4 and 5 above were in conformance with the rules of the Michigan Board of Land Surveyors or by a Decree of a Court of Law; established, re-established, monumented, recovered, found as expressed below:

NOTE: Not more than 2 corners, all in the same town and range, may be recorded on this certificate.

ACCEPTED BY THE MACKINAC COUNTY SURVEY PEER GROUP AS THE OFFICIAL CORNER UNDER P.A. 345 OF 1990 AT A MEETING HELD ON 12-04-98 NEH

A. Description of original monument and accessories and/or subsequent restoration:

1845	GLO Notes J Mullett	6" Aspen	N 40 E	23 lks
		20" W Pine	S 38 W	23 lks
1977	Larry Feindt	8" Twin Maple	S 30 E	44.32'
	Set 1 ¼" Pipe in CL of road	14" W Pine	Due W	49.72'
	and on line with ¼ and section	6" Spruce	N 45 E	57.03'
	corners to the East			
	Liber A, Page 198			

1997 R.S. Scott Associates Recovered a ¾" iron Pipe.
Remonumentation peer group held over corner due to lack of information

B. Description of corner evidence found and/or method applied in restoring or reestablishing corner:

1998 Fd 1 ¼" pipe in Mon Box 1' East of centerline of 3-Mile Rd
Accepted corner location
Placed ½" re-bar inside pipe to attach 4" Alum. remonumentation cap

C. Description of monument for corner and accessories established to perpetuate locating the position of the corner:

Corner is 1 ¼" pipe with 4" Alum. remonumentation cap in mon box
Corner is 1.0' East of CL of 3-mile Rd

24" W Pine	N 85 W	50.23'
4" Cedar	N 74 E	36.34'
6" Spruce	N 45 W	47.98'
8" Spruce	N 45 E	57.13'

STATE OF MICHIGAN
NEIL E. HILL
Land Surveyor
No. 27447
REGISTERED LAND SURVEYOR

Bearings are compass bearings, corrected for declination, all distances are to a double-headed nail in the side of the witness object unless otherwise noted.

Signed by Neil E. Hill P.S. Date 12-29-98

Surveyor's Michigan License No. 27447

FORM APPROVED BY MICHIGAN STATE BOARD OF PROFESSIONAL SURVEYORS, JAN. 28, 1971
REVISED MAY 14, 1975
REVISED JAN., 1983
REVISED OCT., 1995

98-52

E - 309