

**SURVEY &  
REMONUMENTATION**

**JAN 21 1999**

**LAND CORNER RECORDATION CERTIFICATE  
Filing Requirement of Act 74, Mich. P.A. 1970**

**SECTION**

**Mackinac County Remonumentation Corner**

For corners in

Mackinac County	Located in:	Corner Code #
1. Public Land Survey	T42N R01W	H-3
	T R	
	T R	
	T R	
2. Property Controlling in Section	S T R	
	S T R	
3. Miscellaneous Property in Sec.	S T R	
	S T R	
4. Lot No. , Recorded Plat		
5. Private Claims		

**RECEIVED & FILED**  
**DIANE FRANKOVICH**  
 MACKINAC COUNTY REGISTER OF DEEDS


**DEC 31 1998**

**AM** **PM**  
 7|8|9|10|11|12|1|2|3|4|5|6

Register of Deeds Stamp & File Number

I, Neil E Hill, in a field survey on 12-21-98, do hereby state that under requirements of P.A. 74, Michigan P.A. of 1970, the corner points mentioned in lines 1 and 2 above were in conformance with regulations and rules therefore as required in the current manual of survey instructions of the United States Department of the Interior, Bureau of Land Management or by a decree of a Court of Law and /or that the corner points mentioned in lines 3, 4 and 5 above were in conformance with the rules of the Michigan Board of Land Surveyors or by a Decree of a Court of Law; established, re-established, monumented, recovered, found as expressed below:

NOTE: Not more than 2 corners, all in the same town and range, may be recorded on this certificate.

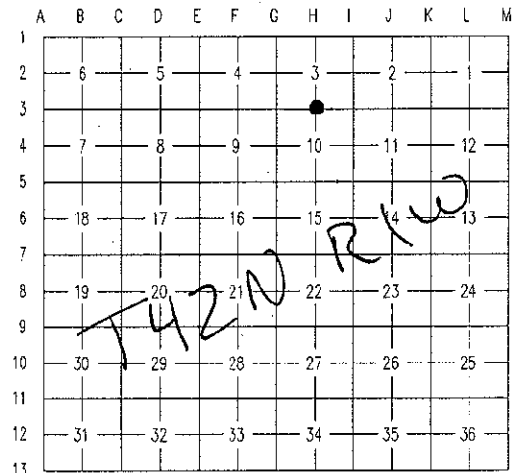

**A. Description of original monument and accessories and/or subsequent restoration:**

1845 GLO Notes James Mullett	6" Beech	N 65 E	10 lks
	4" Beech	S 43W	13 lks
1988 R Bischer	16" Beech	N 22 E	9.62 ft
Set 1/2" Rod	20" Lynn	N 60 W	21.30 ft
Liber C, Page 330	6" Maple	N 80 E	8.20 ft

ACCEPTED BY THE MACKINAC COUNTY SURVEY PEER GROUP AS THE OFFICIAL CORNER UNDER P.A. 345 OF 1990 AT A MEETING HELD ON 12-11-98 NEH

**B. Description of corner evidence found and/or method applied in restoring or reestablishing corner:**

1998 Fd 1/2 re-rod Cap #22428 and 2 witnesses  
 Accepted corner location  
 Placed 4" Alum. remonumentation cap

**C. Description of monument for corner and accessories established to perpetuate locating the position of the corner:**

Corner is a 1/2" re-rod with 4" Alum. remonumentation cap  
 Corner is Approx 75" North of logging trial

24" Basswood	N 60 W	21.22'
18" Basswood	S 50 E	15.32'
18" Maple	N 60 W	8.56'
6" Maple	N 80 E	8.27'



Bearings are compass bearings, corrected for declination, all distances are to a double-headed nail in the side of the witness object unless otherwise noted.

Signed by Neil E. Hill P.S.

Date 12-29-98

Surveyor's Michigan License No. 27447