

LAND CORNER RECORDATION CERTIFICATE
Filing Requirement of Act 74, Mich. P.A. 1970

MAR 22 1999

Mackinac County Remonumentation Corner

For corners in

Mackinac County

Located in: Seg. #2 Corner Code #

- | | | | |
|------------------------------------|---|-----------|---------------|
| 1. Public Land Survey | | T42N R01W | <u>K-1</u> |
| | | T43N R01W | K-13 |
| | | T | R |
| | | T | R |
| 2. Property Controlling in Section | S | T | R |
| | S | T | R |
| 3. Miscellaneous Property in Sec. | S | T | R |
| | S | T | R |
| 4. Lot No. | | | Recorded Plat |
| 5. Private Claims | | | |

SECTION
RECEIVED & FILED
DIANE FRANKOVICH
MACKINAC COUNTY REGISTER OF DEEDS

MAR 17 1999
AM PM
7|8|9|10|11|12|1|2|3|4|5|6

Register of Deeds Stamp & File Number

	A	B	C	D	E	F	G	H	I	J	K	L	M
1													
2	6	5	4	3	2								
3													
4	7	8	9	10	11								
5													
6	18	17	16	15	14								
7													
8	19	20	21	22	23	24							
9													
10	30	29	28	27	26	25							
11													
12	31	32	33	34	35	36							
13													

I, Neil E Hill, in a field survey on 12-21-98, do hereby state that under requirements of P.A. 74, Michigan P.A. of 1970, the corner points mentioned in lines 1 and 2 above were in conformance with regulations and rules therefore as required in the current manual of survey instructions of the United States Department of the Interior, Bureau of Land Management or by a decree of a Court of Law and /or that the corner points mentioned in lines 3, 4 and 5 above were in conformance with the rules of the Michigan Board of Land Surveyors or by a Decree of a Court of Law; established, re-established, monumented, recovered, found as expressed below:

NOTE: Not more than 2 corners, all in the same town and range, may be recorded on this certificate.

A. Description of original monument and accessories and/or subsequent restoration:

- | | | | | |
|------------------------------|-------------|--------|--------|---------------|
| 1845 GLO Notes James Mullett | 6" Spruce | N 74 E | 14 lks | |
| | 7" Spruce | N 43 W | 22 lks | |
| 1998 R Bischer | 20" Hemlock | S 27 E | 22.46' | (Old witness) |
| Fd 1/2" rod (H Goodwin?) | 13" Hemlock | N 55 W | 7.35' | (Old witness) |
| | 16" Hemlock | S 38 W | 20.62' | |
| | 9" Cedar | N 28 E | 13.64' | |

ACCEPTED BY THE MACKINAC COUNTY SURVEY PEER GROUP AS THE OFFICIAL CORNER UNDER P.A. 345 OF 1990 AT A MEETING HELD ON 12-14-99 NEH


B. Description of corner evidence found and/or method applied in restoring or reestablishing corner:

- 1998 Fd 1/2" rod and 4 old witnesses
Accepted corner location
Placed 4" Alum. remonumentation cap

C. Description of monument for corner and accessories established to perpetuate locating the position of the corner:

Corner is a 1/2" rod with 4" Alum. remonumentation cap

- | | | |
|--------------------|--------|-------|
| 20" Hemlock S 27 E | 22.46' | (Old) |
| 13" Hemlock N 55 W | 7.35' | (Old) |
| 16" Hemlock S 38 W | 20.62' | |
| 9" Cedar N 28 E | 13.64' | |

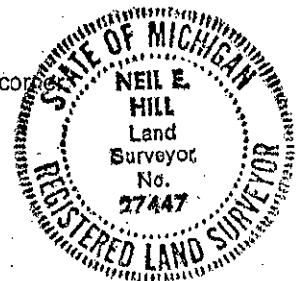

Bearings are compass bearings, corrected for declination, all distances are to a nail and tag in the side of the witness object unless otherwise noted.

** NOTE : This corner is being re-recorded to correct an erroneous Range designation for the code K-13 (K-13 is R01W, Not R01E, as previously recorded in E - 327)

Signed by Neil E. Hill P.S.P.C.

Date 3-17-99

Surveyor's Michigan License No. 27447