SURVEY &
REMONUMENTATION

MAR 20 2000

SECTION

LAND CORNER RECORDATION CERTIFICATE
Filing Requirement of Act 74, Mich. P.A. 1970

Mackinac County Remonumentation Corner

For corners in

Mackinac County	Located in:			Corner Code #
1. Public Land Survey		T42N	R01W	K-12
		T	R	
		T	R	
		T	R	
2. Property Controlling	S	T	R	
in Section	S	T	R	
3. Miscellaneous	S	T	R	
Property in Sec.	S	T	R	

4. Lot No. , Recorded Plat
5. Private Claims

RECEIVED & FILED
DIANE FRANKOVICH
MACKINAC COUNTY REGISTER OF DEEDS

FEB 25 2000

AM FM
7|8|9|10|11|12|1|2|3|4|5|6

Register of Deeds Stamp & File Number

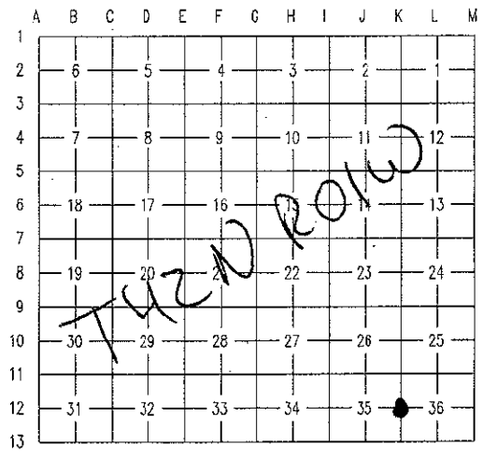

I, Neil E. Hill, in a field survey on 12-20-99, do hereby state that under requirements of P.A. 74, Michigan P.A. of 1970, the corner points mentioned in lines 1 and 2 above were in conformance with regulations and rules therefore as required in the current manual of survey instructions of the United States Department of the Interior, Bureau of Land Management or by a decree of a Court of Law and /or that the corner points mentioned in lines 3, 4 and 5 above were in conformance with the rules of the Michigan Board of Land Surveyors or by a Decree of a Court of Law; established, re-established, monumented, recovered, found as expressed below:

NOTE: Not more than 2 corners, all in the same town and range, may be recorded on this certificate.

ACCEPTED BY THE MACKINAC COUNTY SURVEY PEER GROUP AS THE OFFICIAL CORNER UNDER P.A. 345 OF 1990 AT A MEETING HELD ON 11-05-99
Neil E. Hill

A. Description of original monument and accessories and/or subsequent restoration:

1845 GLO Notes A Burt	6" Maple	S 55 E	17 lks
	6" Sugar	S 75 W	9 lks

No Subsequent Information

B. Description of corner evidence found and/or method applied in restoring or reestablishing corner:

1999 Fd no evidence of original or subsequent corners
Set ½ rod with 4" Alum. remonumentation cap online and at GLO distance from Section corner to the North and the WCMC to the South

C. Description of monument for corner and accessories established to perpetuate locating the position of the corner:

Corner is a ½" rod with 4" Alum. remonumentation cap
Corner is in the fairway of gold coarse
Corner is 88' West of a mound with large rock, and East 63' of another mound

8" Spruce	S 35 E	133.56'
14" Cedar	N 50 W	271.46'
10" T Balsam	N 55 E	276.48'
16" Pine	S 75 E	522.82'

STATE OF MICHIGAN
NEIL E. HILL
Land Surveyor
No. 27447
REGISTERED LAND SURVEYOR

Bearings are compass bearings, corrected for declination, all distances are to a double- head nail in the side of the witness object unless otherwise noted.

Signed by Neil E. Hill P.S.P.C. Date January 21 2000

Surveyor's Michigan License No. 27447

FORM APPROVED BY MICHIGAN STATE BOARD OF PROFESSIONAL SURVEYORS, JAN. 28, 1971
REVISED MAY 14, 1975
REVISED JAN., 1983
REVISED OCT., 1995

1999-41

F 00003