

MACKINAC COUNTY REMONUMENTATION
LAND CORNER RECORDATION CERTIFICATE
 Filing Requirement of Act 74, Mich. P.A. 1970

RECEIVED & FILED
 DIANE FRANKOVICH
 MACKINAC COUNTY REGISTER OF DEEDS

NOV - 7 1995

AM PM
 7|8|9|10|11|12|1|2|3|4|5|6



Register of Deeds Stamp & File Number

For corners in
Mackinac
 (County)

Located In: Corner Code ##

- | | | | | | | |
|------------------------------------|---|------------|---|-----------|---|--------------|
| 1. Public Land Survey | T | <u>42N</u> | R | <u>5W</u> | | <u>A-7</u> ✓ |
| | T | | R | <u>6W</u> | | <u>M-7</u> |
| | T | | R | | | |
| | T | | R | | | |
| 2. Property Controlling in Section | S | | T | | R | |
| | S | | T | | R | |
| 3. Miscellaneous Property in Sec. | S | | T | | R | |
| | S | | T | | R | |

4. Lot No. _____, Recorded Plat _____
 5. Private Claims _____

I, James H. Granger, in a field survey on October 4, 1995, do hereby certify that under requirements of P.A. 74, Michigan P.A. of 1970, the corner points mentioned in lines 1 and 2 above were in conformance with regulations and rules therefore as required in the current manual of survey instructions of the United States Department of the Interior, Bureau of Land Management or by a decree of a Court of Law and/or that the corner points mentioned in lines 3, 4 and 5 above were in conformance with the rules of the Michigan Board of Land Surveyors or by a Decree of a Court of Law; established, re-established, monumented, re-monumented, recovered, found as expressed below:

NOTE: Not more than 4 corners, all in the same town and range, may be recorded on this certificate.

	A	B	C	D	E	F	G	H	I	J	K	L	M
2		6		5		4		3		2		1	
3													
4		7		8		9		10		11		12	
5													
6		18		17		16		15		14		13	
7													
8		19		20		21		22		23		24	
9													
10		30		29		28		27		26		25	
11													
12		31		32		33		34		35		36	
13													

A. Description of original monument and accessories and/or subsequent restoration:

- 1845 Original Survey set wood post 20"beech S39°W 25 lks. 12"beech North 4 lks. Austin Burt
- 1915 D. Brotherton
- 1984 USFS-Michael Lange #30089 set USFS mon.

B. Description of corner evidence found and/or method applied in restoring or reestablishing corner:

Fd. USFS Monument and 4 witnesses.

SURVEY & REMONUMENTATION

DEC 01 1995

COMMISSION


ACCEPTED BY THE MACKINAC COUNTY SURVEY PEER GROUP AS THE OFFICIAL CORNER UNDER P.A. 345 OF 1990 AT A MEETING HELD ON 9-18-95

James H. Granger

C. Description of monument for corner and accessories established to perpetuate locating the position of the corner:

USFS Monument

- 6"pine N57°W 2.00' fd. nail
- 5"pine S16°W 10.28' fd. nail
- 8"pine S40°E 14.63' fd. nail
- 6"pine N69°E 4.31' fd. nail

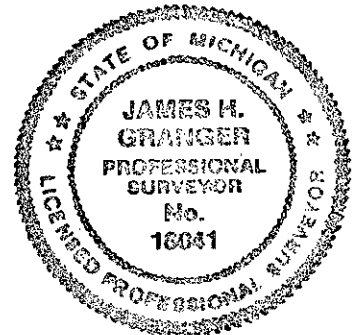

Signed by James H. Granger

Date 10/27/95

Surveyor's Michigan License No. 16041

D - 0370