

MACKINAC COUNTY REMONUMENTATION

LAND CORNER RECORDATION CERTIFICATE
Filing Requirement of Act 74, Mich. P.A. 1970

RECEIVED & FILED
DIANE FRANKOVICH
MACKINAC COUNTY REGISTER OF DEEDS

For corners in

Mackinac
(County)

Located In:

Corner Code ##

- | | | | | | |
|------------------------------------|---|-----|---|----|------------|
| 1. Public Land Survey | T | 42N | R | 5W | <u>B-7</u> |
| | T | | R | | |
| | T | | R | | |
| | T | | R | | |
| 2. Property Controlling in Section | S | | T | R | |
| | S | | T | R | |
| 3. Miscellaneous Property in Sec. | S | | T | R | |
| | S | | T | R | |

NOV - 7 1995
AM PM
7|8|9|10|11|12|1|2|3|4|5|6

Register of Deeds Stamp & File Number

4. Lot No. _____, Recorded Plat _____
5. Private Claims _____

	A	B	C	D	E	F	G	H	I	J	K	L	M
2	6		5		4		3		2		1		
3													
4	7		8		9		10		11		12		
5													
6	18		17		16		15		14		13		
7	●												
8	19		20		21		22		23		24		
9													
10	30		29		28		27		26		25		
11													
12	31		32		33		34		35		36		
13													

I, James H. Granger, in a field survey on October 4, 19 95, do hereby certify that under requirements of P.A. 74, Michigan P.A. of 1970, the corner points mentioned in lines 1 and 2 above were in conformance with regulations and rules therefore as required in the current manual of survey instructions of the United States Department of the Interior, Bureau of Land Management or by a decree of a Court of Law and/or that the corner points mentioned in lines 3, 4 and 5 above were in conformance with the rules of the Michigan Board of Land Surveyors or by a Decree of a Court of Law; established, re-established, monumented, re-monumented, recovered, found as expressed below:

NOTE: Not more than 4 corners, all in the same town and range, may be recorded on this certificate.

A. Description of original monument and accessories and/or subsequent restoration:

1845 Original Survey set wood post 8"beech N27°W 14 lks. 14"beech S82°W 21 lks.
H. Brevoort

1915 D. Brotherton

B. Description of corner evidence found and/or method applied in restoring or reestablishing corner:

Fd. USFS Monument and 3 witnesses.

**SURVEY &
REMONUMENTATION**

DEC 01 1995

COMMISSION


ACCEPTED BY THE MACKINAC COUNTY
SURVEY PEER GROUP AS THE
OFFICIAL CORNER UNDER P.A.
345 OF 1990 AT A MEETING
HELD ON 9-18-95

James H. Granger

C. Description of monument for corner and accessories established to perpetuate locating the position of the corner:

USFS Monument

- | | | | |
|---------|-------|--------|----------|
| 8"pine | N24°E | 15.06' | fd. nail |
| 10"pine | S22°E | 31.46' | fd. nail |
| 14"pine | S81°W | 23.36' | fd. nail |
| 6"pine | N22°W | 14.39' | set tag |

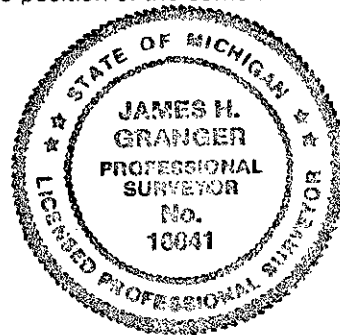

Signed by James H. Granger

Date 10/27/95

Surveyor's Michigan License No. 16041