

MACKINAC COUNTY REMONUMENTATION

LAND CORNER RECORDATION CERTIFICATE
Filing Requirement of Act 74, Mich. P.A. 1970

RECEIVED 8 11
MACKINAC COUNTY

NOV - 7 1995

AM 7:18 | 9 | 10 | 11 | 12 | 13 | 14 | 15 | 16

For corners in
Mackinac
(County)

Located In: Corner Code #1

- 1. Public Land Survey T 42N R ^{SW} 6W D-7
- T _____ R _____
- T _____ R _____
- T _____ R _____
- 2. Property Controlling S _____ T _____ R _____
- in Section S _____ T _____ R _____
- 3. Miscellaneous S _____ T _____ R _____
- Property in Sec. S _____ T _____ R _____

Seg. #1

Register of Deeds Stamp & File Number

- 4. Lot No. _____, Recorded Plat _____
- 5. Private Claims _____

	A	B	C	D	E	F	G	H	I	J	K	L	M
2	6	5	4	3	2	1							
3													
4	7	8	9	10	11	12							
5													
6	18	17	16	15	14	13							
7		●											
8	19	20	21	22	23	24							
9													
10	30	29	28	27	26	25							
11													
12	31	32	33	34	35	36							
13													

I, James H. Granger, in a field survey on October 4, 1995

do hereby certify that under requirements of P.A. 74, Michigan P.A. of 1970, the corner points mentioned in lines 1 and 2 above were in conformance with regulations and rules therefore as required in the current manual of survey instructions of the United States Department of the Interior, Bureau of Land Management or by a decree of a Court of Law and/or that the corner points mentioned in lines 3, 4 and 5 above were in conformance with the rules of the Michigan Board of Land Surveyors or by a Decree of a Court of Law; established, re-established, monumented, re-monumented, recovered, found as expressed below:

NOTE: Not more than 4 corners, all in the same town and range, may be recorded on this certificate.

A. Description of original monument and accessories and/or subsequent restoration:

1845 Original Survey set wood post 13" beech S57°E 21 lks. 15" beech S44°W 58 lks.
H. Brevoort

1915 D. Brotherton
1985 USFS-Michael Lange #30089 1/2" iron

B. Description of corner evidence found and/or method applied in restoring or reestablishing corner:

Worth Road reconstructed. Ex. 1/2" iron and witnesses measured by Northwoods Inc. prior to construction. Iron removed during construction.


ACCEPTED BY THE MACKINAC COUNTY
SURVEY PEER GROUP AS THE
OFFICIAL CORNER UNDER P.A.
345 OF 1990 AT A MEETING
HELD ON 9-18-95

James H. Granger

C. Description of monument for corner and accessories established to perpetuate locating the position of the corner:

Set 5/8" rebar with remonumentation cap inside monument box.

- 6" maple N53°E 102.43' fd tag
- 11" maple S49°E 116.92' fd tag
- 8" maple S38°W 54.71' fd tag
- 11" spruce N41°W 77.92' fd tag

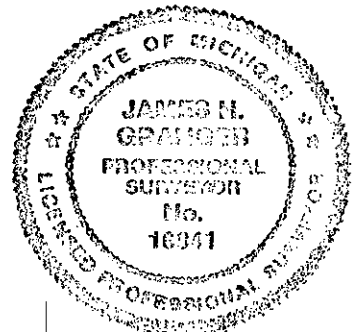

Signed by *James H. Granger*

Date 10/27/95

Surveyor's Michigan License No. 16041

D - 0361