

MACKINAC COUNTY REMONUMENTATION
 LAND CORNER RECORDATION CERTIFICATE
 Filing Requirement of Act 74, Mich. P.A. 1970

RECEIVED & FILED
 DIANE FRANKOVICH
 MACKINAC COUNTY REGISTER OF DEEDS

JUL 22 1996

AM PM
 7|8|9|10|11|12|1|2|3|4|5|6

For corners in
Mackinac
 (County)

Located In: _____ Corner Code ~~##~~ _____

1. Public Land Survey T 42N R 5W D-7
 T _____ R _____
 T _____ R _____
 T _____ R _____
 T _____ R _____

2. Property Controlling S _____ T _____ R _____
 in Section S _____ T _____ R _____

3. Miscellaneous S _____ T _____ R _____
 Property in Sec. S _____ T _____ R _____

Register of Deeds Stamp & File Number

4. Lot No. _____, Recorded Plat _____
 5. Private Claims _____

I, James H. Granger, in a field survey on October 4, 19 95, do hereby certify that under requirements of P.A. 74, Michigan P.A. of 1970, the corner points mentioned in lines 1 and 2 above were in conformance with regulations and rules therefore as required in the current manual of survey instructions of the United States Department of the Interior, Bureau of Land Management or by a decree of a Court of Law and/or that the corner points mentioned in lines 3, 4 and 5 above were in conformance with the rules of the Michigan Board of Land Surveyors or by a Decree of a Court of Law; established, re-established, monumented, re-monumented, recovered, found as expressed below:

NOTE: Not more than 4 corners, all in the same town and range, may be recorded on this certificate.

A	B	C	D	E	F	G	H	I	J	K	L	M
2	6	5	4	3	2	1						
3												
4	7	8	9	10	11	12						
5												
6	16	17	16	15	14	13						
7												
8	19	20	21	22	23	24						
9												
10	30	29	28	27	26	25						
11												
12	31	32	33	34	35	36						
13												

A. Description of original monument and accessories and/or subsequent restoration:

1845 Original Survey set wood post 13" Beech S 57°E 21 lks.
 H. Brevoort 15" Beech S 44°W 58 lks.

1915 D. Brotherton

1985 USFS-Michael Lange #30089 12" iron

B. Description of corner evidence found and/or method applied in restoring or reestablishing corner:


Worth road reconstructed. Ex. 1/2" iron and witnesses measured by Northwoods Inc. prior to construction. Iron removed during construction.

ACCEPTED BY THE MACKINAC COUNTY
 SURVEY PEER GROUP AS THE
 OFFICIAL CORNER UNDER P.A.
 345 OF 1990 AT A MEETING
 HELDON 9-18-95

C. Description of monument for corner and accessories established to perpetuate locating the position of the corner:

Set 5/8" rebar with remonumentation cap inside monument box.

6" Maple N53°E 102.43' fd tag
 11" Maple S49°E 116.92' fd tag
 8" Maple S38°W 54.71' fd tag
 11" Spruce N41°W 77.92' fd tag

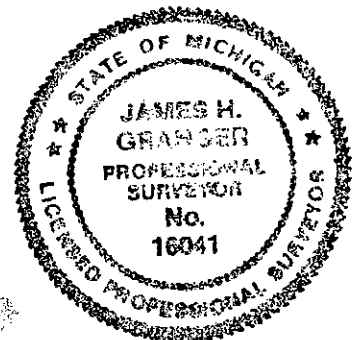

This replaces previous LCRC recorded in Liber D, page 0361

Signed by James H. Granger Date 7-22-96
 Surveyor's Michigan License No. 16041