

**SURVEY &
REMONUMENTATION**

APR 28 1995

MACKINAC COUNTY REMONUMENTATION

COMMISSION

LAND CORNER RECORDATION CERTIFICATE
Filing Requirement of Act 74, Mich. P.A. 1970

For corners in

| | | |
|--|--------------------------|-----------------------|
| <u>Mackinac</u> <small>(County)</small> | Located In: | Corner Code <u>##</u> |
| 1. Public Land Survey | T <u>42N</u> R <u>5W</u> | <u>F-7</u> |
| | T _____ R _____ | _____ |
| | T _____ R _____ | _____ |
| | T _____ R _____ | _____ |
| 2. Property Controlling in Section | S _____ T _____ R _____ | _____ |
| | S _____ T _____ R _____ | _____ |
| 3. Miscellaneous Property in Sec. | S _____ T _____ R _____ | _____ |
| | S _____ T _____ R _____ | _____ |

Register of Deeds Stamp & File Number

4. Lot No. _____, Recorded Plat _____
5. Private Claims _____

| | | | | | | | | | | | | | |
|----|----|----|----|----|----|----|---|---|---|---|---|---|---|
| | A | B | C | D | E | F | G | H | I | J | K | L | M |
| 2 | 6 | 5 | 4 | 3 | 2 | 1 | | | | | | | |
| 3 | | | | | | | | | | | | | |
| 4 | 7 | 8 | 9 | 10 | 11 | 12 | | | | | | | |
| 5 | | | | | | | | | | | | | |
| 6 | 18 | 17 | 16 | 15 | 14 | 13 | | | | | | | |
| 7 | | | | | | | | | | | | | |
| 8 | 19 | 20 | 21 | 22 | 23 | 24 | | | | | | | |
| 9 | | | | | | | | | | | | | |
| 10 | 30 | 29 | 28 | 27 | 26 | 25 | | | | | | | |
| 11 | | | | | | | | | | | | | |
| 12 | 31 | 32 | 33 | 34 | 35 | 36 | | | | | | | |
| 13 | | | | | | | | | | | | | |

James H. Granger, in a field survey on August 9, 19 94,
do hereby certify that under requirements of P.A. 74, Michigan P.A. of 1970, the corner points mentioned
in lines 1 and 2 above were in conformance with regulations and rules therefore as required in the
current manual of survey instructions of the United States Department of the Interior, Bureau of Land
Management or by a decree of a Court of Law and/or that the corner points mentioned in lines 3, 4 and 5
above were in conformance with the rules of the Michigan Board of Land Surveyors or by a Decree of a
Court of Law; established, re-established, monumented, re-monumented, recovered, found as
expressed below:

**NOTE: Not more than 4 corners, all in the same town and range, may be recorded
on this certificate.**

A. Description of original monument and accessories and/or subsequent restoration:

- 1845 Original Survey Set wood post 8" Cedar N82°W 11 lks, 12" Tamarack S12°E 17 lks.
H. Brevoort
- 1915 D.A. Brotherton No evidence found

B. Description of corner evidence found and/or method applied in restoring or reestablishing corner:

Placed 5/8" rebar w/aluminum cap in Monument Box, one-half the distance and on line between the
SW section corner and the SE section corner


ACCEPTED BY THE MACKINAC COUNTY
SURVEY PEER GROUP AS THE
OFFICIAL CORNER UNDER P.A.
345 OF 1990 AT A MEETING
HELD ON 10-17-94

James H. Granger

C. Description of monument for corner and accessories established to perpetuate locating the position of the corner:

5/8" rebar w/aluminum cap in Monument Box

- 8" Poplar S39°W 38.86'
- 4" Spruce S33°E 44.48'
- 6" Poplar N21°E 58.98'
- 8" Poplar N23°W 73.54'

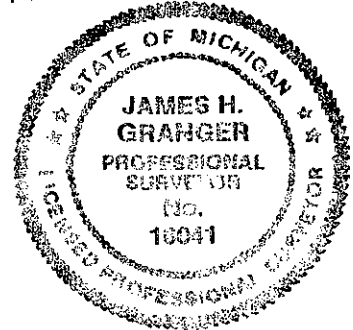

Signed by James H. Granger Date 11-16-94
Surveyor's Michigan License No. 16041