

**SURVEY &
REMONUMENTATION**

APR 28 1995

COMMISSION

MACKINAC COUNTY REMONUMENTATION

**LAND CORNER RECORDATION CERTIFICATE
Filing Requirement of Act 74, Mich. P.A. 1970**

For corners in

Mackinac
(County)

Located In:

Corner Code #

- | | | |
|---------------------------------------|--------------------------|------------|
| 1. Public Land Survey | T <u>42N</u> R <u>5W</u> | <u>I-7</u> |
| | T _____ R _____ | _____ |
| | T _____ R _____ | _____ |
| | T _____ R _____ | _____ |
| 2. Property Controlling
in Section | S _____ T _____ R _____ | _____ |
| | S _____ T _____ R _____ | _____ |
| 3. Miscellaneous
Property in Sec. | S _____ T _____ R _____ | _____ |
| | S _____ T _____ R _____ | _____ |

Register of Deeds Stamp & File Number

4. Lot No. _____, Recorded Plat _____
5. Private Claims _____

	A	B	C	D	E	F	G	H	I	J	K	L	M
2	6		5		4		3		2		1		
3													
4	7		8		9		10		11		12		
5													
6	18		17		16		15		14		13		
7													
8	19		20		21		22		23		24		
9													
10	30		29		28		27		26		25		
11													
12	31		32		33		34		35		36		
13													

I, James H. Granger, in a field survey on August 9, 19 94, do hereby certify that under requirements of P.A. 74, Michigan P.A. of 1970, the corner points mentioned in lines 1 and 2 above were in conformance with regulations and rules therefore as required in the current manual of survey instructions of the United States Department of the Interior, Bureau of Land Management or by a decree of a Court of Law and/or that the corner points mentioned in lines 3, 4 and 5 above were in conformance with the rules of the Michigan Board of Land Surveyors or by a Decree of a Court of Law; established, re-established, monumented, re-monumented, recovered, found as expressed below:

NOTE: Not more than 4 corners, all in the same town and range, may be recorded on this certificate.

A. Description of original monument and accessories and/or subsequent restoration:

1845 Original Survey Set Wood Post, 12" Birch S51°W 13 lks, 12" Aspen N21½°E 19 lks
H. Brevoort

B. Description of corner evidence found and/or method applied in restoring or reestablishing corner:


Placed 5/8" rebar w/ aluminum cap in Monument Box. Prorated the measured distance from the SW corner of Section 15 to the SE corner of Section 14 to GLO. Placed on a straight line between the 2 section corners.

ACCEPTED BY THE MACKINAC COUNTY
SURVEY PEER GROUP AS THE
OFFICIAL CORNER UNDER P.A.
345 OF 1990 AT A MEETING
HELD ON 10-17-94

James H. Granger

C. Description of monument for corner and accessories established to perpetuate locating the position of the corner:

6" Ironwood	S36°W	42.24'	5/8" rebar w/aluminum cap in Monument Box
12" Basswood	S26°E	38.30'	
3" Birch	N38°W	50.09'	
3" Spruce	N39°E	52.42'	

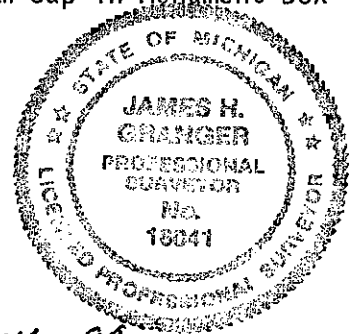

Signed by James H. Granger Date 11-16-94
Surveyor's Michigan License No. 16041

D-0335