

# SURVEY & REMONUMENTATION

APR 28 1995

MACKINAC COUNTY REMONUMENTATION

COMMISSION

**LAND CORNER RECORDATION CERTIFICATE**  
Filing Requirement of Act 74, Mich. P.A. 1970

For corners in

Mackinac <small>(County)</small>	Located In:	Corner Code #	
1. Public Land Survey	T <u>42N</u> R <u>5W</u>	<u>J-7</u>	
	T _____ R _____	_____	
	T _____ R _____	_____	
	T _____ R _____	_____	
2. Property Controlling in Section	S _____ T _____ R _____	_____	
	S _____ T _____ R _____	_____	
3. Miscellaneous Property in Sec.	S _____ T _____ R _____	_____	
	S _____ T _____ R _____	_____	

Register of Deeds Stamp & File Number

4. Lot No. \_\_\_\_\_, Recorded Plat \_\_\_\_\_

5. Private Claims \_\_\_\_\_

	A	B	C	D	E	F	G	H	I	J	K	L	M
2	6	5	4	3	2	1							
3													
4	7	8	9	10	11	12							
5													
6	18	17	16	15	14	13							
7										●			
8	19	20	21	22	23	24							
9													
10	30	29	28	27	26	25							
11													
12	31	32	33	34	35	36							
13													

I, James H. Granger, in a field survey on August 9, 19 94, do hereby certify that under requirements of P.A. 74, Michigan P.A. of 1970, the corner points mentioned in lines 1 and 2 above were in conformance with regulations and rules therefore as required in the current manual of survey instructions of the United States Department of the Interior, Bureau of Land Management or by a decree of a Court of Law and/or that the corner points mentioned in lines 3, 4 and 5 above were in conformance with the rules of the Michigan Board of Land Surveyors or by a Decree of a Court of Law; established, re-established, monumented, re-monumented, recovered, found as expressed below:


**NOTE: Not more than 4 corners, all in the same town and range, may be recorded on this certificate.**

A. Description of original monument and accessories and/or subsequent restoration:  
 1845 Original Survey Set Wood Post, 12" Birch S82°W 15 lks, 5" Aspen N47°W 21 lks  
 H. Brevoort

B. Description of corner evidence found and/or method applied in restoring or reestablishing corner:  
 Placed 5/8" rebar w/ aluminum cap in Monument Box one half the distance and on line between the SW section corner and the SE section corner.

ACCEPTED BY THE MACKINAC COUNTY  
SURVEY PEER GROUP AS THE  
OFFICIAL CORNER UNDER P.A.  
345 OF 1990 AT A MEETING  
HELD ON 10-17-94  
*James H. Granger*

C. Description of monument for corner and accessories established to perpetuate locating the position of the corner:  
 5/8" rebar w/aluminum cap in Monument Box  
 6" Spruce S42°E 52.55'  
 12" Poplar N56°E 66.63'  
 4" Spruce N05°E 43.02'  
 12" Spruce N41°W 77.42'

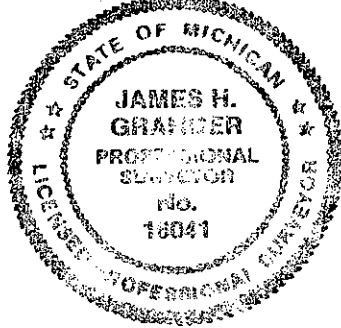

Signed by James H. Granger Date 11-16-94  
 Surveyor's Michigan License No. 16041

12-01-94