

**SURVEY &
REMONUMENTATION**

APR 28 1995

COMMISSION LAND CORNER RECORDATION CERTIFICATE
Filing Requirement of Act 74, Mich. P.A. 1970

For corners in
Mackinac

(County)

Located In:

Corner Code ≠#

- | | | | | | | |
|---------------------------------------|---|------------|---|-----------|------------|-------|
| 1. Public Land Survey | T | <u>42N</u> | R | <u>5W</u> | <u>L-7</u> | |
| | T | _____ | R | _____ | _____ | |
| | T | _____ | R | _____ | _____ | |
| | T | _____ | R | _____ | _____ | |
| 2. Property Controlling
in Section | S | _____ | T | _____ | R | _____ |
| | S | _____ | T | _____ | R | _____ |
| 3. Miscellaneous
Property in Sec. | S | _____ | T | _____ | R | _____ |
| | S | _____ | T | _____ | R | _____ |

Register of Deeds Stamp & File Number

4. Lot No. _____, Recorded Plat _____
5. Private Claims _____

	A	B	C	D	E	F	G	H	I	J	K	L	M
2	6	5	4	3	2	1							
3													
4	7	8	9	10	11	12							
5													
6	18	17	16	15	14	13							
7													
8	19	20	21	22	23	24							
9													
10	30	29	28	27	26	25							
11													
12	31	32	33	34	35	36							
13													

I, James H. Granger, in a field survey on August 9, 19 94, do hereby certify that under requirements of P.A. 74, Michigan P.A. of 1970, the corner points mentioned in lines 1 and 2 above were in conformance with regulations and rules therefore as required in the current manual of survey instructions of the United States Department of the Interior, Bureau of Land Management or by a decree of a Court of Law and/or that the corner points mentioned in lines 3, 4 and 5 above were in conformance with the rules of the Michigan Board of Land Surveyors or by a Decree of a Court of Law; established, re-established, monumented, re-monumented, recovered, found as expressed below:


NOTE: Not more than 4 corners, all in the same town and range, may be recorded on this certificate.

A. Description of original monument and accessories and/or subsequent restoration:

1845 Original Survey, Set wood post, 8" Aspen N65°E 9 lks, 6" Balsam S69°W 12 lks
H. Brevoort

B. Description of corner evidence found and/or method applied in restoring or reestablishing corner:

Fd PK nail set by Neil Hill, P.S. based on MDOT R.O.W. Plans. Set 5/8" rebar w/aluminum cap in Monument Box.

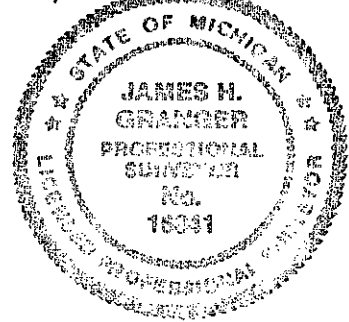

C. Description of monument for corner and accessories established to perpetuate locating the position of the corner:

5/8" rebar w/aluminum cap in Monument Box

- | | | |
|----------|-------|--------|
| PP | N23°W | 80.78' |
| Fc. Cor. | S18°E | 37.80' |
| PP | S43°W | 53.79' |
| Fc. Post | S70°W | 72.49' |

ACCEPTED BY THE MACKINAC COUNTY SURVEY PEER GROUP AS THE OFFICIAL CORNER UNDER P.A. 345 OF 1990 AT A MEETING HELD ON 10-17-94

James H. Granger

Signed by James H. Granger
Surveyor's Michigan License No. 16041

Date 11-16-94

D-0342