

MICHIGAN
DEPARTMENT OF CONSERVATION
FORESTRY DIVISION

LAND CORNER RECORD

T. 42N N.R. 6W


Mackinac COUNTY

DESCRIPTION OF CORNER 1/4 between sections 8-9

CORNER MONUMENT 1" pipe with 4" brass cap.

DATE MONUMENT PLACED AND WITNESSED 4-23-62 with R. Bolz

WITNESSES TO CORNER..... 4" Red Pine (NBT) S38°W, 111 links

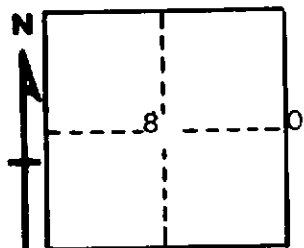

10" Jackpine (1/4 S NBT) N80°W, 113 links

AND

CIRCLE CORNER REGISTERED

DESCRIPTION IN DETAIL AS TO HOW CORNER WAS LOCATED AND IDENTIFIED OR RESTORED.

This corner was replaced from two original B.T.'s in place. One W. Pine bearing S15°E, 23 links. A stump in poor condition with notch and lower part of blaze in evidence. One Y. Pine stump bearing S37°W, 13 links. Stump badly burned with no identifying marks. Found traces of stake in soil. Corner lies 82 links south of road.

SURVEYOR'S SEAL

SIGNED Billy D. Buckler DATE July 19, 1963
REGISTERED LAND SURVEYOR
Billy D. Buckler