

MICHIGAN
DEPARTMENT OF CONSERVATION
FORESTRY DIVISION

LAND CORNER RECORD

T. 42 N.R. 6W


Mackinac COUNTY

DESCRIPTION OF CORNER East 1/8 corner for sections 6-7

CORNER MONUMENT 1" pipe with 4" aluminum cap

DATE MONUMENT PLACED AND WITNESSED 9-22-61

WITNESSES TO CORNER..... 14" W. Pine Stump (BT) N18°W 28 1/2 links

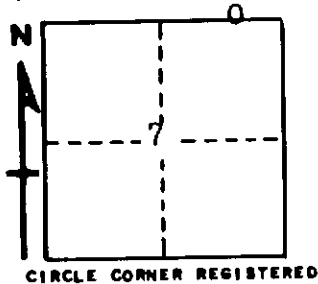

15" " " " " S21°E 21 links

AND

DESCRIPTION IN DETAIL AS TO HOW CORNER WAS LOCATED AND IDENTIFIED OR RESTORED.

This corner was placed midway and on line between Section Corner to East and 1/4 corner to West.

SURVEYOR'S SEAL

SIGNED Billy D. Buckler DATE March 14, 1962
REGISTERED LAND SURVEYOR
Billy D. Buckler