

MICHIGAN  
DEPARTMENT OF CONSERVATION  
FORESTRY DIVISION

# LAND CORNER RECORD

T. 42N N.R. 6W

Mackinac COUNTY


DESCRIPTION OF CORNER Section corner common to sections 9-10-15-16

CORNER MONUMENT 1" pipe with aluminum cap.

DATE MONUMENT PLACED AND WITNESSED 4-24-62

WITNESSES TO CORNER..... 16" W. Pine (S16 NBT) S45°W, 217½ links

16" W. Pine (S16 NBT) S1°W, 198 links

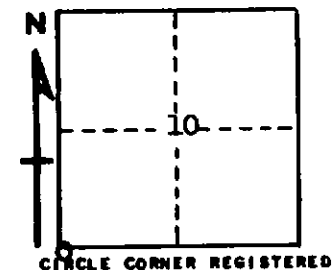

AND

DESCRIPTION IN DETAIL AS TO HOW CORNER WAS LOCATED AND IDENTIFIED OR RESTORED.

This corner was re-established on an old line of blazes and by proportionate distance between corners 1 mile east and 3 miles west.

No evidence of original corner.

SURVEYOR'S SEAL

SIGNED Billy D. Buckler DATE April 29, 1963  
REGISTERED LAND SURVEYOR  
Billy D. Buckler