

SEC. 31, T. 43 N. R. 6 W.

SEC. 32, T. 43 N. R. 6 W.

SEC. LINE

STANDARD
CORNER

18.5'


TOWNSHIP LINE

CLOSING CORNER

SEC. 6, T. 42 N. R. 6 W.

SEC. 5, T. 42 N. R. 6 W.

CLOSING LINE

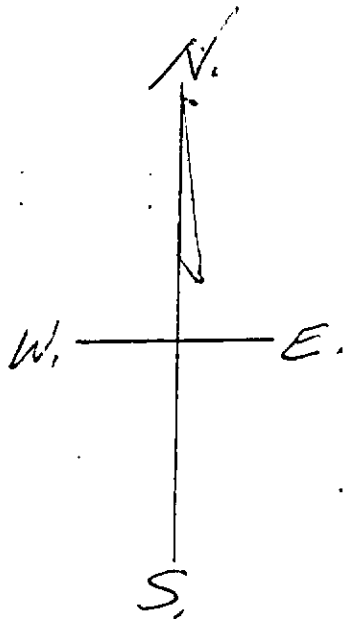

9/20/77

BDB