
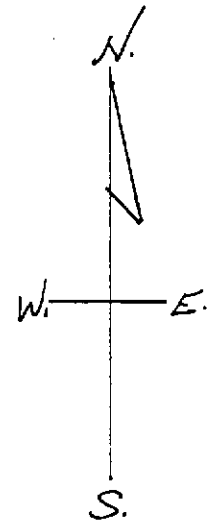



Sub-division

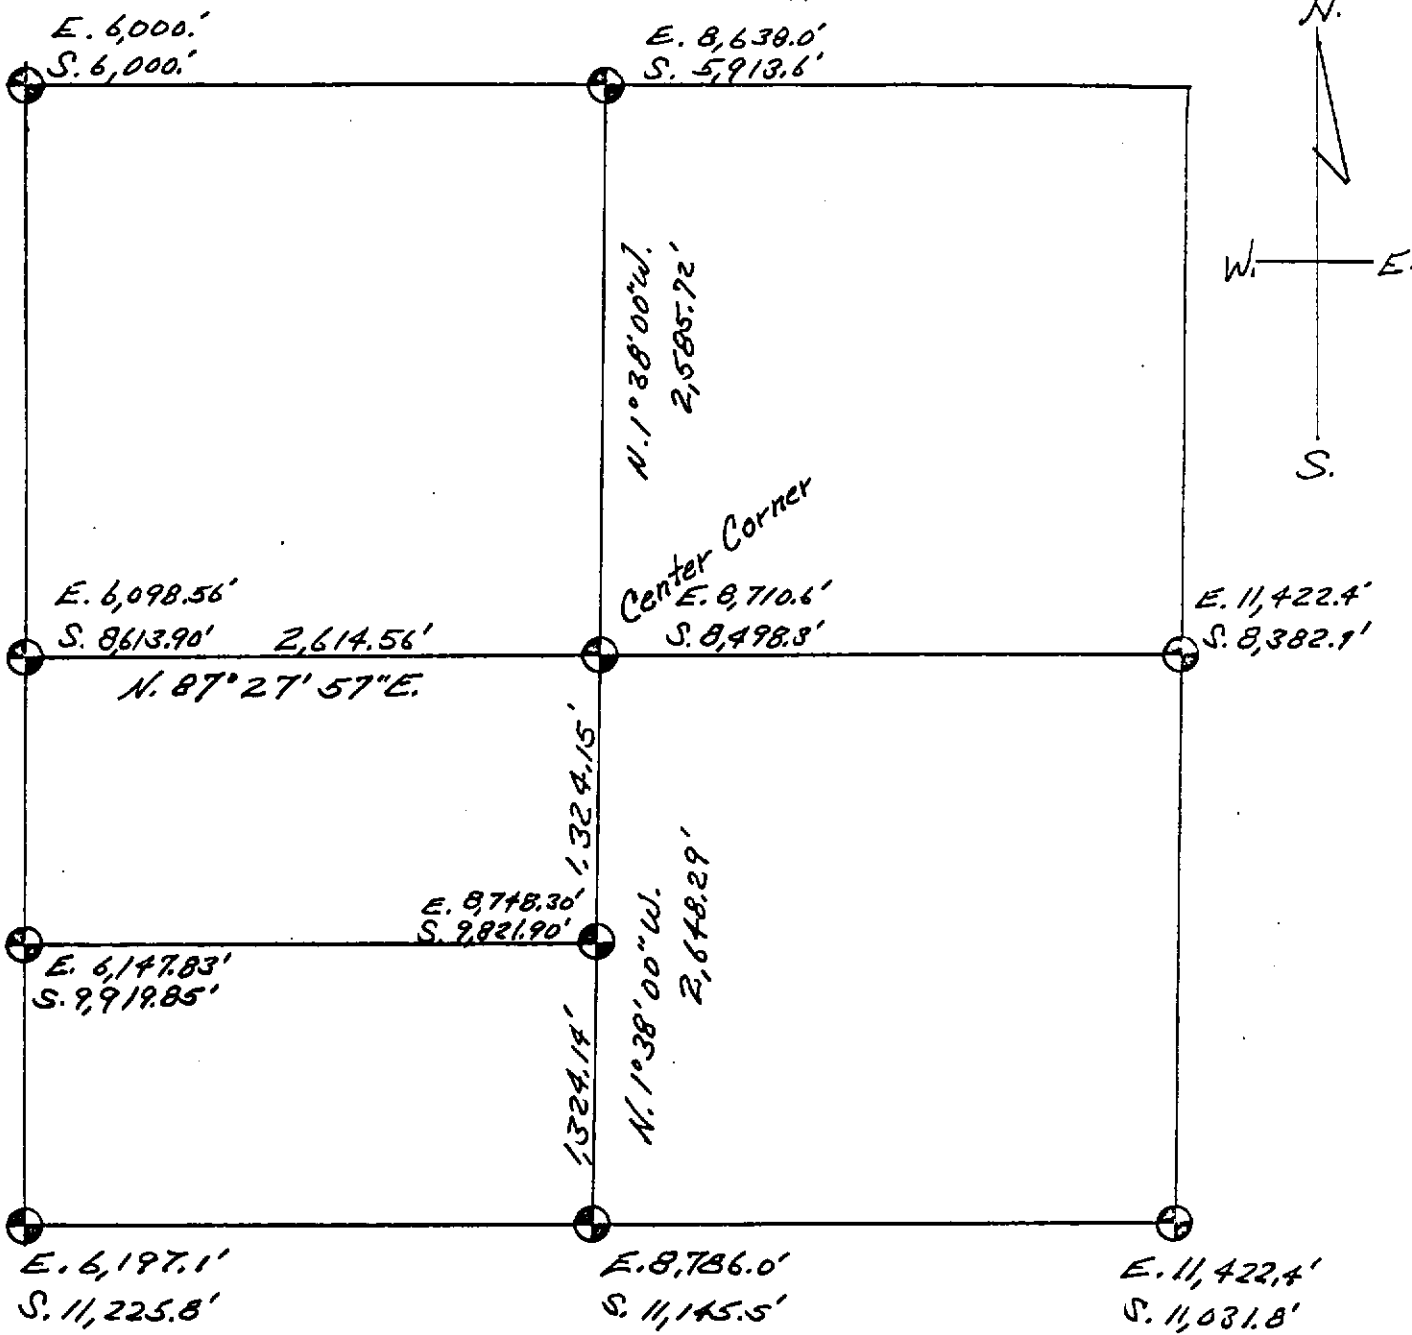

--- Dep't. Marker.

Billy D. Buckler, R.L.S.