


EAST 1/2, SEC. 15, T43N R7W.

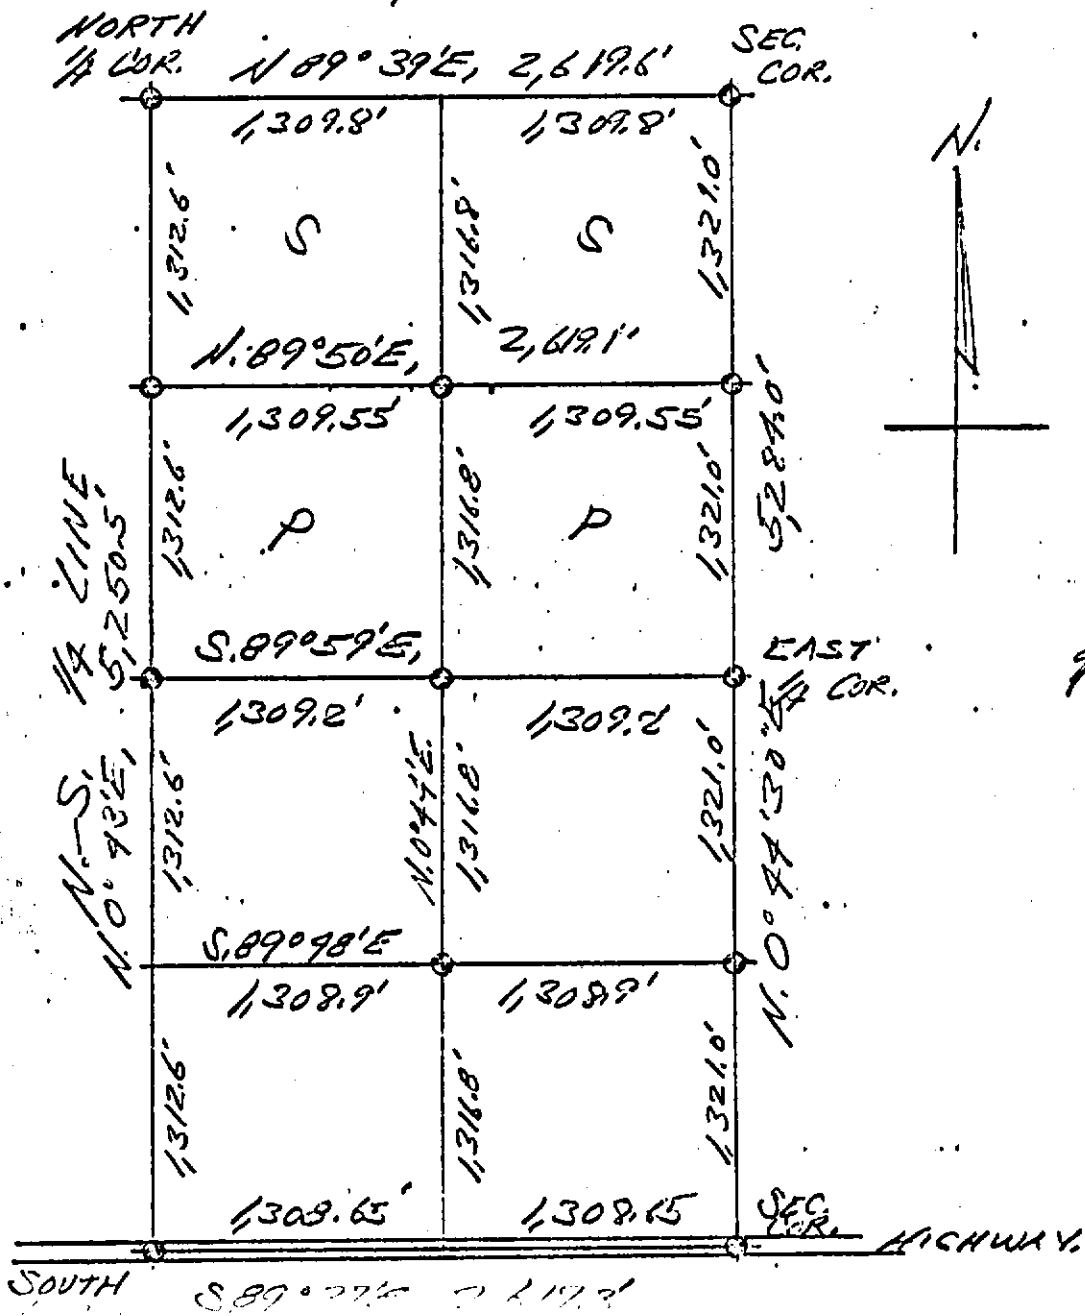

BDB
9/27/76

HIGHWAY