

LAND CORNER RECORDATION CERTIFICATE

FILING REQUIREMENT OF ACT 74, MICH. P.A. 1970
 Mackinac Co. Three Corners

FOR CORNERS OF--:	LOCATED IN--:	CORNER CODE NUMBER
1. PUBLIC LAND SURVEY _____	T. <u>42</u> ^{N.} S. , R. <u>6</u> ^{E.} W.	K-7 E-7 D-7
2. PROPERTY CONTROLLING IN SECTION _____	T. _____, S., R. _____	_____
3. MISCELLANEOUS PROPERTY IN SECTION _____	T. _____, S., R. _____	_____
4. LOT NO. _____, RECORDED PLAT _____		
5. PRIVATE CLAIMS _____		


REGISTER OF DEEDS STAMP AND FILING NUMBER

I, Billy D. Buckler do hereby certify that under requirements of P.A. 74, Michigan P.A. of 1970, the corner points mentioned in lines 1 and 2 above (identified with circles on index code diagram - over) were, in a field survey on 5/6 1968, established, re-established, monumented, re-monumented, recovered or restored as expressed below and in conformance with regulations and rules therefore as required in the current manual of survey instructions of the United States Department of the Interior, Bureau of Land Management or by a decree of a court of law. Furthermore, that the corner points mentioned in lines 3, 4 and 5 above were, in a field survey on _____ 19____, found, recovered, restored, established or re-established as expressed below and in conformance with the rules of the Michigan State Board of Registration for Land Surveyors or, by a Decree of a Court of law:

- A. Description of original monument and accessories and/or subsequent restoration:**
- K-7 Sec. Cor. 13-14-23-24, set by H. Brevoort, Jr. D.S. in 1845.
Bearings were: Beech 18", N60°E, 12 lks. and Beech 12", S87°W, 30 lks.
 - E-7 Sec. Cor. 16-17-20-21, set by H. Brevoort, Jr. D.S. in 1845.
Bearings were: Birch 8", S2°E, 29 lks. and Birch 12", N24°W, 29 lks.
 - D-7 Quarter Corner bet. Sec's. 17-20.
Bearings were: Beech 10", N17°E, 24 lks. and B. Oak 10", S18°E, 32 lks.
- B. Description of corner evidence found and/or method applied in restoring or re-establishing corner:**
- K-7 Corner replaced according to a map of survey by D. A. Brotherton, R.L.S. 1917., while surveying the route of Mackinac County Trunkline road. Corner lies in line with Sec. Cor.; one mile to East and one mile West.
 - E-7 Corner re-witnessed as set by D. A. Brotherton, 1915. Found remains of witnesses: Hemlock 6", N24°W, 43.0' and Pine 14", South, 48.0'.
 - D-7 Placed corner midway and on line bet two Sec. Cors. and on edge of Escarpment.
- C. Description of monument for corner and accessories established to perpetuate locating the position of the corner:**
- K-7 Placed 1" pipe with 4" aluminium cap at corner.
New bearings: 9" Y. Birch, N1°E, 21.7' and 9" S. Maple, S47°E, 23.3' and 12" S. Maple, S83°W, 6.5'
Corner lies 201.5' North of road center line.
 - E-7 New Witnesses: 8" Red Oak, N24°W, 60.2' and 7" Red Oak, S23°W, 67.0'
 - D-7 Placed 1" pipe with 4" aluminium cap at corner on edge of Escarpment.
New Witnesses: 10" Red Oak, S83°E, 26.7' and 12" Red Oak, N25°E, 62.8'

SIGNED BY Billy D. Buckler DATE 4-2-74

SURVEYOR'S MICHIGAN REGISTRATION NO. 8887

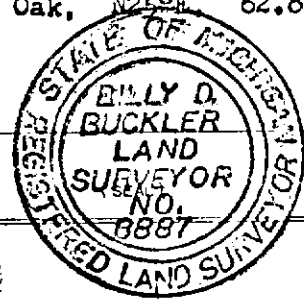

FOR STATE AND UNITED STATES AGENCIES:

SIGNED BY _____ DATE _____
CHIEF OF SURVEY PARTY

APPROVED AND SIGNED BY _____ DATE _____
MICHIGAN REGISTERED LAND SURVEYOR

(SEAL)