

MACKINAC COUNTY REMONUMENTATION
 LAND CORNER RECORDATION CERTIFICATE
 Filing Requirement of Act 74, Mich. P.A. 1970

RECEIVED & FILED
 DIANE FRANKOVICH
 MACKINAC COUNTY REGISTER OF DEEDS

For corners in

Mackinac
 (County)

Located In:

Corner Code #

- | | | | | | |
|------------------------------------|---|------------|---|-----------|------------|
| 1. Public Land Survey | T | <u>42N</u> | R | <u>6W</u> | <u>E-7</u> |
| | T | _____ | R | _____ | _____ |
| | T | _____ | R | _____ | _____ |
| | T | _____ | R | _____ | _____ |
| 2. Property Controlling in Section | S | _____ | T | _____ | _____ |
| | S | _____ | T | _____ | _____ |
| 3. Miscellaneous Property in Sec. | S | _____ | T | _____ | _____ |
| | S | _____ | T | _____ | _____ |

NOV - 7 1995
 AM PM
 7|8|9|10|11|12|1|2|3|4|5|6

Register of Deeds Stamp & File Number

4. Lot No. _____, Recorded Plat _____
 5. Private Claims _____

I, James H. Granger, in a field survey on October 4, 19 95, do hereby certify that under requirements of P.A. 74, Michigan P.A. of 1970, the corner points mentioned in lines 1 and 2 above were in conformance with regulations and rules therefore as required in the current manual of survey instructions of the United States Department of the Interior, Bureau of Land Management or by a decree of a Court of Law and/or that the corner points mentioned in lines 3, 4 and 5 above were in conformance with the rules of the Michigan Board of Land Surveyors or by a Decree of a Court of Law; established, re-established, monumented, re-monumented, recovered, found as expressed below:

A	B	C	D	E	F	G	H	I	J	K	L	N
2	6	5	4	3	2	1						
3												
4	7	8	9	10	11	12						
5												
6	18	17	16	15	14	13						
7												
8	19	20	21	22	23	24						
9												
10	30	29	28	27	26	25						
11												
12	31	32	33	34	35	36						
13												

NOTE: Not more than 4 corners, all in the same town and range, may be recorded on this certificate.

A. Description of original monument and accessories and/or subsequent restoration:

- 1845 Original Survey set wood post 8"birch S 2°E 29 lks. 8"birch N24°W 29 lks.
H. Brevoort
- 1915 D. Brotherton
- 1963 DNR-Billy Buckler #8887 Iron pin
- 1974 DNR-Billy Buckler #8887 Iron pin
- 1975 Lawrence Feindt #21566 1/4" iron rod

B. Description of corner evidence found and/or method applied in restoring or reestablishing corner:

Worth Road reconstructed. Ex.iron and witnesses measured by Northwoods Inc. prior to construction. Fd. rotted stumps and old blazed oak that fit Buckler and Feindt witnesses and all agreed with position measured by Northwoods.

SURVEY &
 REMONUMENTATION

DEC 01 1995

COMMISSION


ACCEPTED BY THE MACKINAC COUNTY
 SURVEY PEER GROUP AS THE
 OFFICIAL CORNER UNDER P.A.
 345 OF 1990 AT A MEETING
 HELDON 9-10-95

James H. Granger

C. Description of monument for corner and accessories established to perpetuate locating the position of the corner:

Set 5/8" rebar with remonumentation cap inside monument box.

- | | | | |
|-------------|-------|--------|--------|
| 16" birch | N45°E | 84.77' | fd tag |
| 12" oak | S30°E | 68.89' | fd tag |
| 9"pine | S31°W | 65.88' | fd tag |
| Tr. 10" oak | N23°W | 60.17' | fd tag |

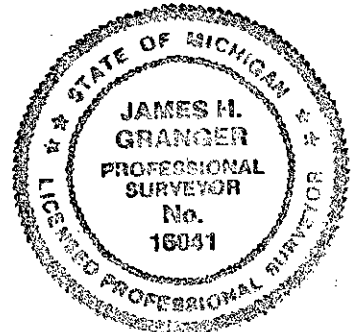

Signed by James H. Granger
 Surveyor's Michigan License No. 16041

Date 10/27/95

D-0362