

MACKINAC COUNTY. REMONUMENTATION
 LAND CORNER RECORDATION CERTIFICATE
 Filing Requirement of Act 74, Mich. P.A. 1970

RECEIVED & FILED
 DIANE FRANKOVICH
 MACKINAC COUNTY REGISTER OF DEEDS

NOV - 7 1995

AM 7|8|9|10|11|12|1|2|3|4|5|6 PM



Register of Deeds Stamp & File Number

For corners in
Mackinac
 (County)

Located In: Corner Code #

1. Public Land Survey	T	42N	R	6W	J-7
	T		R		
	T		R		
	T		R		
2. Property Controlling in Section	S		T	R	
	S		T	R	
3. Miscellaneous Property in Sec.	S		T	R	
	S		T	R	

4. Lot No. _____, Recorded Plat _____
 5. Private Claims _____

I, James H. Granger, in a field survey on October 4, 1995, do hereby certify that under requirements of P.A. 74, Michigan P.A. of 1970, the corner points mentioned in lines 1 and 2 above were in conformance with regulations and rules therefore as required in the current manual of survey instructions of the United States Department of the Interior, Bureau of Land Management or by a decree of a Court of Law and/or that the corner points mentioned in lines 3, 4 and 5 above were in conformance with the rules of the Michigan Board of Land Surveyors or by a Decree of a Court of Law; established, re-established, monumented, re-monumented, recovered, found as expressed below:

A	B	C	D	E	F	G	H	I	J	K	L	M
2	6	5	4	3	2	1						
3												
4	7	8	9	10	11	12						
5												
6	18	17	16	15	14	13						
7												
8	19	20	21	22	23	24						
9												
10	30	29	28	27	26	25						
11												
12	31	32	33	34	35	36						
13												

NOTE: Not more than 4 corners, all in the same town and range, may be recorded on this certificate.

A. Description of original monument and accessories and/or subsequent restoration:
 1845 Original Survey set wood post 4" beech S60°W 11 lks. 6" birch N21°E 11 lks.
 H. Brevoort
 1974 Lawrence Feindt #21566 fd. 3/4" pipe


B. Description of corner evidence found and/or method applied in restoring or reestablishing corner:
 Fd. 3/4" pipe in monument box. witnesses gone.

SURVEY &
 REMONUMENTATION
 DEC 01 1995
 COMMISSION

ACCEPTED BY THE MACKINAC COUNTY
 SURVEY PEER GROUP AS THE
 OFFICIAL CORNER UNDER P.A.
 345 OF 1990 AT A MEETING
 HELDON 9-18-95
James H. Granger

C. Description of monument for corner and accessories established to perpetuate locating the position of the corner:
 Set 5/8" rebar with remonumentation cap inside monument box.

14" maple	S64°W	16.64'	set tag
Powerpole	N26°W	58.39'	set tag
8" maple	N41°E	21.00'	set tag
20" beech	S47°E	26.06'	set tag
CL Worth Rd.	South	81'+	

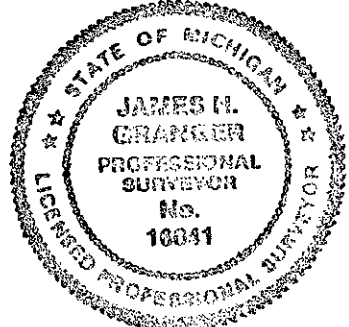

Signed by James H. Granger Date 10/27/95
 Surveyor's Michigan License No. 16041

D-0367