

MACKINAC COUNTY REMONUMENTATION

LAND CORNER RECORDATION CERTIFICATE
Filing Requirement of Act 74, Mich. P.A. 1970

RECEIVED & FILED
DIANE FRANKOVICH
MACKINAC COUNTY REGISTRE. OF DEEDS

NOV - 7 1995

AM 7 | 8 | 9 | 10 | 11 | 12 | 1 | 2 | 3 | 4 | 5 | 6 PM



Register of Deeds Stamp & File Number

For corners in
Mackinac

(County)

Located In:

Corner Code #

1. Public Land Survey	T	42N	R	6W	K-7
	T		R		
	T		R		
	T		R		
2. Property Controlling In Section	S		T	R	
	S		T	R	
3. Miscellaneous Property in Sec.	S		T	R	
	S		T	R	

4. Lot No. _____, Recorded Plat _____
5. Private Claims _____

I, James H. Granger, in a field survey on October 4, 1995, do hereby certify that under requirements of P.A. 74, Michigan P.A. of 1970, the corner points mentioned in lines 1 and 2 above were in conformance with regulations and rules therefore as required in the current manual of survey instructions of the United States Department of the Interior, Bureau of Land Management or by a decree of a Court of Law and/or that the corner points mentioned in lines 3, 4 and 5 above were in conformance with the rules of the Michigan Board of Land Surveyors or by a Decree of a Court of Law; established, re-established, monumented, re-monumented, recovered, found as expressed below:

NOTE: Not more than 4 corners, all in the same town and range, may be recorded on this certificate.

A. Description of original monument and accessories and/or subsequent restoration:

1845 Original Survey set wood post 18"beech N60°E 12 lks. 12"beech S87°W 30 lks.
H. Brevoort

1915 D. Brotherton
1968 DNR-Billy Buckler #8887 Set DNR mon.
1974 Lawrence Feindt #21566 fd. DNR mon.
1990 Gerald Wiggins #23521 fd. DNR mon.

B. Description of corner evidence found and/or method applied in restoring or reestablishing corner:

Fd. DNR Monument and 3 witness trees with no witness nails or tags.

	A	B	C	D	E	F	G	H	I	J	K	L	M
2	6	5	4	3	2	1							
3													
4	7	8	9	10	11	12							
5													
6	18	17	16	15	14	13							
7													
8	19	20	21	22	23	24							
9													
10	30	29	28	27	26	25							
11													
12	31	32	33	34	35	36							
13													

SURVEY &
REMONUMENTATION

DEC 01 1995

COMMISSION


ACCEPTED BY THE MACKINAC COUNTY
SURVEY PEER GROUP AS THE
OFFICIAL CORNER UNDER P.A.
345 OF 1990 AT A MEETING
HELD ON 9-18-95

James H. Granger

C. Description of monument for corner and accessories established to perpetuate locating the position of the corner:

DNR Monument

14"birch	N14°W	28.34'	set tag in prev. witness tree
5" maple	N68°W	26.00'	set tag in prev. witness tree
10"birch	S18°W	9.97'	set tag in prev. witness tree
10"birch	N86°E	14.94'	set tag new witness
CL Worth Rd.	South	100' ±	

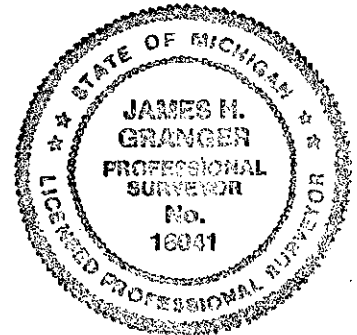

Signed by James H. Granger

Date 10/27/95

Surveyor's Michigan License No. 16041

D - 0368