

LAND CORNER RECORDATION CERTIFICATE
Filing Requirement of Act 74, Mich. P.A. 1970

For corners in

<u>Mackinac</u>	Located In:	Corner Code #
(County)		
1. Public Land Survey	T <u>42N</u> R <u>6W</u>	<u>H3</u>
	T <u>42N</u> R <u>6W</u>	<u>H5</u>
	T _____ R _____	_____
	T _____ R _____	_____
2. Property Controlling in Section	S _____ T _____ R _____	_____
	S _____ T _____ R _____	_____
3. Miscellaneous Property in Sec.	S _____ T _____ R _____	_____
	S _____ T _____ R _____	_____

Register of Deeds Stamp & File Number

4. Lot No. _____, Recorded Plat _____
 5. Private Claims _____

H5 Aug 23 2004
 H3 Aug 30 2004

I, Stephan J. Szyszkoski, in a field survey on _____, 19____ do hereby state that under requirements of P.A. 74, Michigan P.A. of 1970, the corner points mentioned in lines 1 and 2 above were in conformance with regulations and rules therefore as required in the current manual of survey instructions of the United States Department of the Interior, Bureau of Land Management or by a decree of a Court of Law and /or that the corner points mentioned in lines 3, 4 and 5 above were in conformance with the rules of the Michigan Board of Land Surveyors or by a Decree of a Court of Law; established, re-established, monumented, recovered, found as expressed below:

NOTE: Not more than 2 corners, all in the same town and range, may be recorded on this certificate.

	A	B	C	D	E	F	G	H	I	J	K	L	M
1													
2	6		5		4			3		2		1	
3								●					
4	7		8		9			10		11		12	
5								●					
6	18		17		16			15		14		13	
7													
8	19		20		21			22		23		24	
9													
10	30		29		28			27		26		25	
11													
12	31		32		33			34		35		36	
13													

A. Description of original monument and accessories and/or subsequent restoration:

(H3) Quarter corner common to Sections 3 and 10. 1962: Reestablished by Billy D. Buckler RLS midway and on line between Section corners. Set 1" pipe with 4" brass cap witnessed by 8" R.Pine North 44 links (29.0')

(H5) Quarter corner common to Sections 10 and 15. 1962: Reestablished by Billy D. Buckler RLS midway and on line between Section corners. Set 1/2"x36" iron bar beneath Ozark Road. Witnesses: 6" Aspen S32W 54.5 links, 14" Aspen S32E 74.5 links.


B. Description of corner evidence found and/or method applied in restoring or reestablishing corner:

(H3) The 1962 monument was not recovered. The 1962 Red Pine NBT was recovered in good condition but I did not regard it, alone, to be sufficient control to reestablish the corner position. Reestablished the corner position by the 1962 method, midway and on the section line between recorded sections corners 2648.62' east and west. From the position thus established, Mr. Buckler's NBT R.Pine notch was found to be N6E (true brg.) 30.3' distant. The corner falls in the north edge of an E-W road.

(H5) The 1962 monument and accessories were not recovered. Reestablished the corner midway and on the section line between Section corners 2621.21' east and west. Mr. Buckler's notes show he measured 2619.6' for the half miles. The corner falls 4' west of the current center of Ozark Rd.

C. Description of monument for corner and accessories established to perpetuate locating the position of the corner:

(H3) Set 1"IDx36" I.pipe with plastic MDNR cap, buried. Blazed, scribed, and set measuring nails in:	(H5) Set 1"IDx36" I.pipe with plastic MDNR cap, buried. Blazed, scribed, and set measuring nails in:
10" J.Pine S47E 36.55' "1/4S NBT"	6" W.Birch clump N37W 15.9' "1/4S NBT"
8" J.Pine N71E 36.05' do	6" Balsam S41W 23.8' do
8" J.Pine N25E 45.6' do	5" W.Birch S79W 20.15' do
14" R.Pine N10E 30.8' "1/4S" *	6" W.Birch East 33.4' do
Bearings are magnetic. Distances are to nail with tag. *denotes the 1962 NBT.	Bearings are magnetic. Distances are to nail with tag.

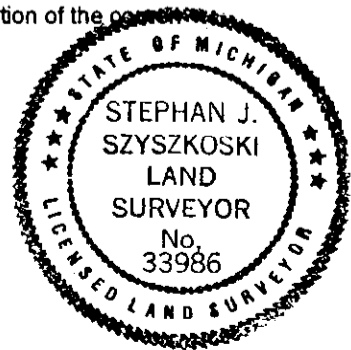

Signed by Stephan J. Szyszkoski
 Surveyor's Michigan License No. 33986

Date 9/15/04