LAND CORNER RECORDATION CERTIFICATE
Filing Requirement of Act 74, Mich. P.A. 1970 as Amended

For corners in

Mackinac
(County)

		Located In:	Corner Code #
1. Public Land Survey		T 42N R 11W	E7
		T R	
		T R	
	S	T R	
2. Property Controlling	S	T R	
in Section	S	T R	
3. Miscellaneous	S	T R	
Property in Sec.	S	T R	

Register of Deeds Stamp & File Number

4. Lot No. _____ , Recorded Plat_____
5. Private Claims

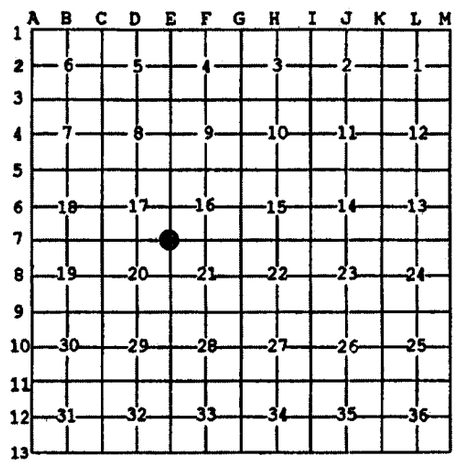

Dec 16 2004

I, Stephan J. Szyszkoski, in a field survey on _____, 20 ____ do hereby state that under requirements of P.A. 74, Michigan P.A. of 1970, the corner points mentioned in lines 1 and 2 above were in conformance with regulations and rules therefore as required in the current manual of survey instructions of the United States Department of the Interior, Bureau of Land Management or by a decree of a Court of Law and /or that the corner points mentioned in lines 3, 4 and 5 above were in conformance with the rules of the Michigan Board of Land Surveyors or by a Decree of a Court of Law; established, re-established, monumented, recovered, found as expressed below:

NOTE: Not more than 2 corners, all in the same town and range, may be recorded on this certificate.

A. Description of original monument and accessories and/or subsequent restoration:

(E7) Corner common to Sections 16-17-20-21. Previously remonumented by David B. Guthrie PS #22435, date unknown. That position was used by Erik Lewicki PS #46676 to subdivide Section 16 in April of 2004. Found no notes of this corner in the Mackinac County Road Commission files.

B. Description of corner evidence found and/or method applied in restoring or reestablishing corner:

(E7) All physical evidence of the original GLO survey was destroyed by road construction long ago. Found a 1/2" iron pin with plastic cap #22435 in a monument box in the centerline intersection of N-S Gould City Road and Simmons Woods Road to the east. The position fits with monumentation found at F7 and G7 as described by Mr. Lewicki: All three corners are on line and F7 is midway between E7 and G7. I accepted the Guthrie position as the best available evidence of the position of the original corner and used the position to reestablish corner E8 and to subdivide Section 21.

C. Description of monument for corner and accessories established to perpetuate locating the position of the corner:

(E7) Fd. 1/2" rebar with cap #22435 in monument box. Set measuring nails in:
Three Power poles:
EN4 177 66, N50E 49.85'
EN4 177 66X, N44W 50.32'
(no ID) S43E 45.45'
Center of project marker S24W 93.4'
Bearings are magnetic. Distances to poles are to nail with tag.

STATE OF MICHIGAN
STEPHAN J. SZYSZKOSKI
LAND SURVEYOR
No. 33986
LICENSED LAND SURVEYOR

Signed by Stephan J. Szyszkoski Date 3/12/07

Surveyor's Michigan License No. 33986

For the Michigan Department of Natural Resources, Office of Land and Facilities

FORM APPROVED BY MICHIGAN STATE BOARD OF PROFESSIONAL SURVEYORS, JAN. 28, 1971
Revised May 14, 1975
Revised Jan., 1983
Rervised Oct., 1995